

Madison
D
2003

MISSISSIPPI
 BOARD OF WATER COMMISSIONERS
 416 North State Street
 Jackson, Mississippi 39201

WATER WELL DRILLERS LOG

9/16
 date well completed

1982 Thomas + Son
 firm name

Madison
 county well located

LANDOWNER: Annie Lee GRIFFIN
Rt 1 Box
Camden Miss
 (mailing address)

description of formations encountered	from	to
<u>Red DIRT</u>	<u>0</u>	<u>6</u>
<u>Red CHALK</u>	<u>6</u>	<u>14</u>
<u>GRAY CHALK</u>	<u>14</u>	<u>70</u>
<u>Fine SAND AND SOME CHALK</u>	<u>70</u>	<u>95</u>
<u>WHITE SAND (Med)</u>	<u>95</u>	<u>128</u>

WELL LOCATION:

sec 30 T 11 N S R 4 E W

(distance) miles (direction) of (nearest town)

WELL PURPOSE:

(home, irrigation, municipal, industrial)

WELL COMPLETION DATA:

- (1) diameter (inches) 2"
- (2) total depth (feet) 120'
- (3) static water level (feet) 40 ^{below} _{above} top of ground.
- (4) casing 2" PVC 110'
 (material) (depth)
2 if telescope see back.
 (size)
- (5) screen 10 , 110
 (length) (depth to top)
2" , PVC
 (size) (material)
- (6) pump 1 , 8
 (HP) (yield gpm)
ELECTRIC
 (type power)
- (7) electric log NO
 (yes or no)

(organization running log)

(8) how well bottom plugged Screen

DEPT. OF NATURAL RESOURCES
 BUREAU OF LAND & WATER RESOURCES


DRILLERS REMARKS:

OCT - 5 1982

RECEIVED

If well telescopes please sketch and show depths.

GROUND LEVEL

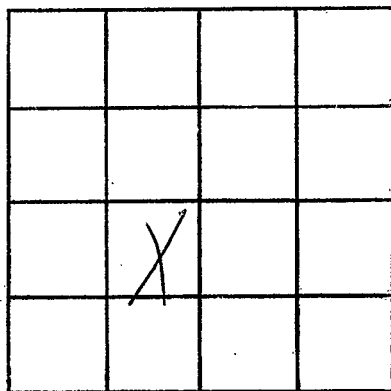

SECTION _____

Please indicate well location X.

ADDITIONAL INFORMATION

If more than one screen,
show locations of each on sketch.