

MISSISSIPPI DEPARTMENT OF NATURAL RESOURCES

Bureau of Land and Water Resources

Southport Mall

P.O. Box 10631

Jackson, Mississippi 39209

WATER WELL DRILLERS LOG

Madison
D
2004

3/9 1983
 date well completed

Thomas + son
 firm name

Madison
 county well located

LANDOWNER	description of formations encountered	from	to
<u>Maeba Branon</u> <u>Rt 5</u>	<u>Red dirt</u>	<u>0</u>	<u>6</u>
<u>Camden Miss</u> (mailing address)	<u>Red sand</u>	<u>6</u>	<u>14</u>
	<u>Grey sand</u>	<u>14</u>	<u>36</u>
	<u>White sand</u>	<u>36</u>	<u>95</u>
WELL LOCATION:			
sec. <u>8</u> T <u>10</u> N R <u>4</u> E			
<u>5</u> miles <u>NE</u> of <u>Camden</u> (distance) (direction) (nearest town)			
WELL PURPOSE:			
(home, irrigation, municipal, industrial)			
WELL COMPLETION DATA:			
(1) diameter (inches) <u>2 1/2</u>			
(2) total depth (feet) <u>95</u>			
(3) static water level (feet) <u>28</u> <u>below</u> <u>above</u> top of ground.			
(4) casing <u>pvc</u> <u>95'</u> (material) (depth) <u>2 1/2</u> if telescope see back. (size)			
(5) screen <u>10'</u> <u>85'</u> (length) (depth to top)			
<u>2 1/2</u> <u>pvc</u> (size) (material)			
(6) pump <u>1</u> <u>10</u> (HP) (yield gpm)			
<u>Electric</u> (type power)			
(7) electric log <u>NO</u> (yes or no)			
(organization running log)			
(8) how well bottom plugged <u>Screen</u>			

DEPT. OF NATURAL RESOURCES
 BUREAU OF LAND & WATER RESOURCES


APR - 4 1983

RECEIVED

DRILLERS REMARKS:

If well telescopes please sketch and show depths.

GROUND LEVEL

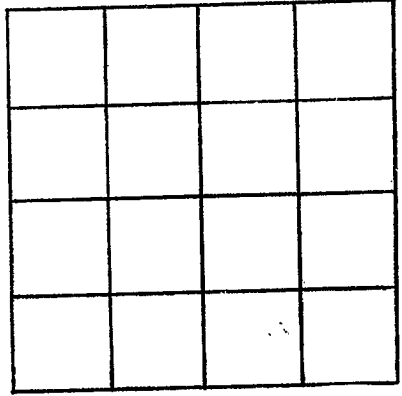

SECTION _____

Please indicate well location X.

ADDITIONAL INFORMATION

If more than one screen,
show locations of each on sketch.