

**MISSISSIPPI DEPARTMENT OF NATURAL RESOURCES**  
**Bureau of Land and Water Resources**  
 Southport Mall  
 P.O. Box 10631  
 Jackson, Mississippi 39209  
**WATER WELL DRILLERS LOG**

Madison  
D  
2006

4-17 1984 Thomas & Son Madison  
 date well completed firm name county well located

LANDOWNER: Billy Tucker

description of formations encountered

from to

Camden Miss  
 (mailing address)

<u>Red sand</u>	<u>0</u>	<u>32</u>
<u>White Fine Sand</u>	<u>32</u>	<u>52</u>
<u>White sand Fine Chalk</u>	<u>52</u>	<u>80</u>
<u>White C. sand</u>	<u>80</u>	<u>110</u>

**WELL LOCATION:**

sec. 33 T. 11 N. R. 4 E.  
6 miles NE of Camden  
 (distance) (direction) (nearest town)

**WELL PURPOSE:**

(home irrigation, municipal, industrial)

**WELL COMPLETION DATA:**

- (1) diameter (inches) 2"
- (2) total depth (feet) 110'
- (3) static water level (feet) 65' below top of ground.
- (4) casing PVC, 110'  
 (material) (depth)  
2" if telescope see back.  
 (size)
- (5) screen 10', 100'  
 (length) (depth to top)  
2", PVC  
 (size) (material)
- (6) pump 1, 6  
 (HP) (yield gpm)  
Electric  
 (type power)
- (7) electric log NO  
 (yes or no)  
 (organization running log)
- (8) how well bottom plugged Screen

DEPT. OF NATURAL RESOURCES  
 BUREAU OF LAND & WATER RESOURCES


APR 30 1984

**RECEIVED**

DRILLERS REMARKS:

If well telescopes please sketch and show depths.

GROUND LEVEL

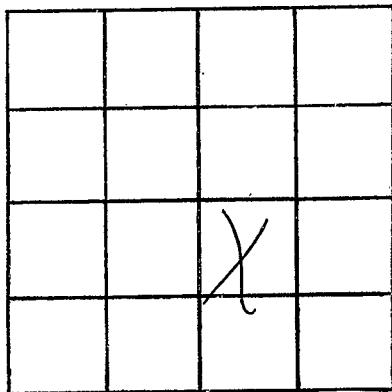

SECTION \_\_\_\_\_

Please indicate well location X.

ADDITIONAL INFORMATION

If more than one screen, show locations of each on sketch.