

E. C. ...

Madison
E 12
12-14-68

MISSISSIPPI
BOARD OF WATER COMMISSIONERS
416 North State Street
Jackson, Mississippi 39201

CODING
CODING

WATER WELL DRILLERS LOG

12-14 1968 *W. S. D. ...* Madison
date well completed firm name county well located

LANDOWNER: *Mathis ...*
Cashlin ...
(mailing address)

description of formations encountered	from	to
	Red Clay	0
Red sand	10	20
Loess sand	20	50
White sand	50	98

WELL LOCATION:
sec. 27 T 11 N R 5 E
S W
3 miles S.W. of Snyder
(distance) (direction) (nearest town)

WELL PURPOSE: *Home*
(home, irrigation, municipal, industrial)

WELL COMPLETION DATA:

- (1) diameter (inches) 4 1/2
- (2) total depth (feet) 99-7 1/2
- (3) static water level (feet) 70 below above top of ground.
- (4) casing 2" 94 1/2'
(material) (depth)
If telescope see back.
(size)
- (5) screen 1/4" 4 1/2'
(length) (depth to top)
2" Aluminum
(size) (material)
- (6) pump _____ (HP) _____ (yield gpm)
(type power)
- (7) electric log None
(yes or no)
(organization running log)
- (8) how well bottom plugged 1/4 plug

CODING


JAN 7 1969

DRILLERS REMARKS:

MISS. BD. OF
WATER COM.

If well telescopes please sketch and show depths.

GROUND LEVEL

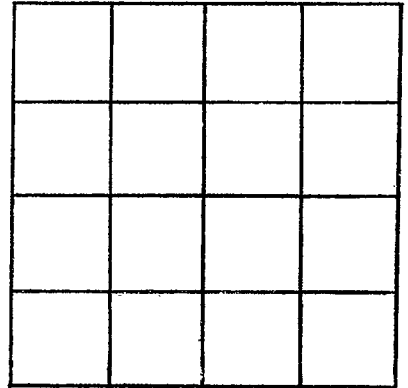

SECTION 27

Please indicate well location X.

ADDITIONAL INFORMATION

If more than one screen, show locations of each on sketch.