

MADISON

E 14

6-12-70

MISSISSIPPI BOARD OF WATER COMMISSIONERS
416 North State Street
Jackson, Mississippi 39201

CODED

WATER WELL DRILLERS LOG

6-12 1970 Thomas Sew MADISON
date well completed firm name county well located

LANDOWNER: Ernest Jobe

Canton, Miss.

(mailing address)

WELL LOCATION:

sec. 1 T. 11N R. 5E
S W

5 1/2 miles NE of Camden
(distance) (direction) (nearest town)

WELL PURPOSE:

(home, irrigation, municipal, industrial)

WELL COMPLETION DATA:

- (1) diameter (inches) 2
- (2) total depth (feet) 145
- (3) static water level (feet) 97 ^{below} _{above} top of ground.
- (4) casing Galv. 140
(material) (depth)
2 if telescope see back.
(size)
- (5) screen 5 140
(length) (depth to top)
1 1/4 slot 5.5
(size) (material)
- (6) pump 1 5
(HP) (yield gpm)
Elec
(type power)
- (7) electric log NO
(yes or no)

(organization running log)

(8) how well bottom plugged

description of formations encountered

from to

<u>Hard Red Clay</u>	<u>0</u>	<u>20</u>
<u>Red Sand</u>	<u>20</u>	<u>102</u>
<u>Hit Cave lost</u>	<u>102</u>	
<u>Returns: Blowed</u>		
<u>Casing Down to 140 ft.</u>		
<u>Inserted Strainer</u>		
<u>to course white sand</u>		

CODED


DRILLERS REMARKS:

MISS. Bd. of
WATER COMMISSIONERS

7 1970

If well telescopes please sketch and show depths.

GROUND LEVEL

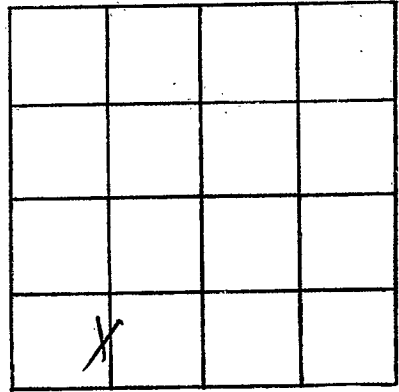

SECTION 1

Please indicate well location X.

ADDITIONAL INFORMATION

If more than one screen,
show locations of each on sketch.