

MISSISSIPPI  
BOARD OF WATER COMMISSIONERS  
416 North State Street  
Jackson, Mississippi 39201

WATER WELL DRILLERS LOG

MADISON

E15

6-569

6-5

1969 W. S. J. Drillers Madison

date well completed

firm name

county well located

LANDOWNER: Giff Adams

Rout 2 Box 86

Candon Miss

(mailing address)

description of formations encountered

from

to

<u>Red clay</u>	<u>0</u>	<u>5</u>
<u>Red sand</u>	<u>5</u>	<u>70</u>
<u>Brown sand</u>	<u>30</u>	<u>50</u>
<u>Pen white sand</u>	<u>50</u>	<u>85</u>
<u>Case white sand</u>	<u>85</u>	<u>132</u>

WELL LOCATION:

sec T 11 N R 5 E

miles of (distance) (direction) (nearest town)

WELL PURPOSE: Home  
(home, irrigation, municipal, industrial)

WELL COMPLETION DATA:

- (1) diameter (inches) 4 1/2
- (2) total depth (feet) 132
- (3) static water level (feet) 75 below above top of ground.
- (4) casing Alum 132  
(material) (depth)
- 3 If telescope see back.  
(size)
- (5) screen 5 127  
(length) (depth to top)
- 1/4 35  
(size) (material)
- (6) pump 3/4 (HP) 30 (yield gpm)
- Clinton  
(type power)
- (7) electric log No  
(yes or no)

(organization running log)

(8) how well bottom plugged 1/2 plugged


DRILLERS REMARKS:

JUN 20 1969

MISS. PUB. OF WATER BOARD

If well telescopes please sketch and show depths.

GROUND LEVEL

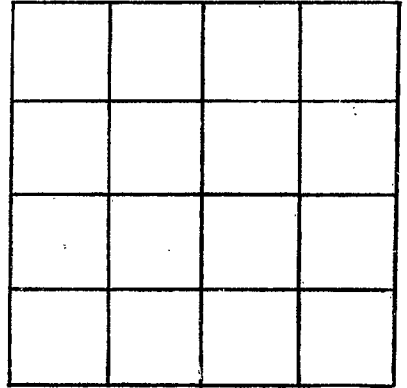

SECTION \_\_\_\_\_

Please indicate well location X.

ADDITIONAL INFORMATION

If more than one screen, show locations of each on sketch.