

MADISON
E16
9-70

MISSISSIPPI
BOARD OF WATER COMMISSIONERS
416 North State Street
Jackson, Mississippi 39201

CODED

WATER WELL DRILLERS LOG

sept 1970 Thomas & Son Madison
date well completed firm name county well located

LANDOWNER: Cozy Singleton
Candem, Miss
(mailing address)

description of formations encountered	from	to
red sand	0	30
CHALK	30	42
Chalky Fine Sand	42	75
Rock	75	
BLACK DIRT	75 1/2	84
Coarse Sand	84	100

WELL LOCATION:
sec 03 T 11 N R 5 E
3 11 3
1 1/2 miles NW of Black Bluff
(distance) (direction) (nearest town)

WELL PURPOSE:
(home) irrigation, municipal, industrial

- WELL COMPLETION DATA:
- (1) diameter (inches) 2
 - (2) total depth (feet) 100
 - (3) static water level (feet) 75 (below above top of ground.)
 - (4) casing Galv 94
(material) (depth)
2 if telescope see back.
(size)
 - (5) screen 6 94
(length) (depth to top)
1 1/4 8 slot S-S.
(size) (material)
 - (6) pump 1 6
(HP) (yield gpm)
Elec.
(type power)
 - (7) electric log no
(yes or no)
(organization running log)
 - (8) how well bottom plugged

CODED


OCT 14 1970

DRILLERS REMARKS:

MISS. Bd. OF
WATER COMM.

If well telescopes please sketch and show depths.

GROUND LEVEL

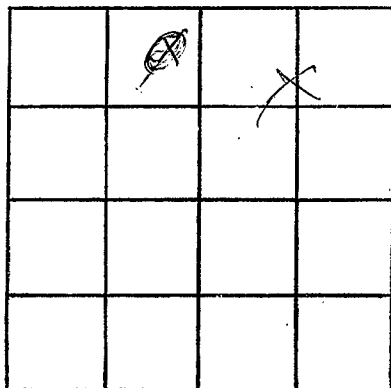

SECTION

Please indicate well location X.

ADDITIONAL INFORMATION

If more than one screen,
show locations of each on sketch.