

MISSISSIPPI  
BOARD OF WATER COMMISSIONERS  
416 North State Street  
Jackson, Mississippi 39201

**CODED**

WATER WELL DRILLERS LOG

MADISON  
E 17  
12-11-70

12-11-70 date well completed  
F.S.J. Dillus firm name  
Madison county well located

LANDOWNER: Louis Smith  
Rt 2, Box 106  
Camden Miss  
(mailing address)

WELL LOCATION:  
sec. 6 T. 11 N. R. 6 E  
7 miles SW of Thomasboro  
(distance) (direction) (nearest town)

WELL PURPOSE: Home  
(home, irrigation, municipal, industrial)

- WELL COMPLETION DATA:
- (1) diameter (inches) 4 1/2
  - (2) total depth (feet) 131
  - (3) static water level (feet) 57 below above top of ground.
  - (4) casing Galv. pipe 127  
(material) (depth)  
no if telescope see back.  
(size)
  - (5) screen 4 127 ft  
(length) (depth to top)  
2 P.B. pipe  
(size) (material)
  - (6) pump 1 900  
(HP) (yield gpm)  
1.50  
(type power)
  - (7) electric log no  
(yes or no)  
None  
(organization running log)
  - (8) how well bottom plugged partially

description of formations encountered	from	to
<u>Red clay</u>	<u>0</u>	<u>10</u>
<u>Red loam</u>	<u>10</u>	<u>30</u>
<u>Bank sand</u>	<u>30</u>	<u>40</u>
<u>White sand</u>	<u>40</u>	<u>100</u>
<u>White sand</u>	<u>100</u>	<u>131</u>

**CODED**


DEC 16 1970

MISS. BD. OF  
WATER COMM.

DRILLERS REMARKS:

If well telescopes please sketch and show depths.

GROUND LEVEL

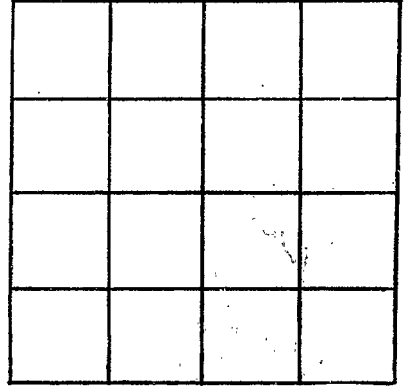

SECTION \_\_\_\_\_

Please indicate well location X.

ADDITIONAL INFORMATION

If more than one screen,  
show locations of each on sketch.