

**MADISON**  
**E 18**  
**11-16-72**

MISSISSIPPI  
 BOARD OF WATER COMMISSIONERS  
 416 North State Street  
 Jackson, Mississippi 39201

**CODED**

**WATER WELL DRILLERS LOG**

Nov. 16 1972 Thomas & Son Madison  
 date well completed firm name county well located

LANDOWNER: Lizie Scott

Camden, Miss:

(mailing address)

description of formations encountered

from

to

<u>Red Dirt</u>	<u>0</u>	<u>18</u>
<u>Red SAND &amp; CHALK</u>	<u>18</u>	<u>50</u>
<u>Course Dry SAND</u>	<u>50</u>	<u>90</u>
<u>White SAND</u>	<u>90</u>	<u>126</u>

WELL LOCATION:

sec. 26 T. 11 N. R. 5 E  
7 1/2 miles SE of Camden  
 (distance) (direction) (nearest town)

WELL PURPOSE:

(home, irrigation, municipal, industrial)

WELL COMPLETION DATA:

- (1) diameter (inches) 2
- (2) total depth (feet) 126
- (3) static water level (feet) 90 below top of ground.
- (4) casing PVC, 121,  
 (material) (depth)  
2 If telescope see back.  
 (size)
- (5) screen 5, 121  
 (length) (depth to top)  
2" 8 slot PVC  
 (size) (material)
- (6) pump 1, 5  
 (HP) (yield gpm)  
elec.  
 (type power)
- (7) electric log NO  
 (yes or no)

(organization running log)

(8) how well bottom plugged point


**CODED**

DRILLERS REMARKS:

JAN 3 1972

If well telescopes please sketch and show depths.

GROUND LEVEL

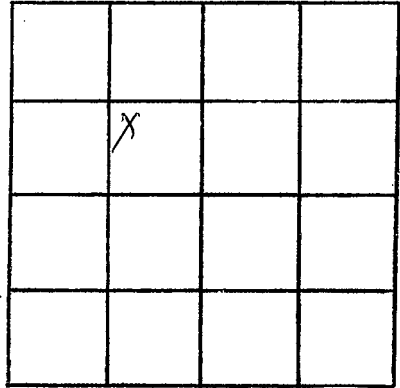

SECTION 26

Please indicate well location X.

ADDITIONAL INFORMATION

If more than one screen,  
show locations of each on sketch.