

E 21  
 MADISON  
 8-13-73

MISSISSIPPI  
 BOARD OF WATER COMMISSIONERS  
 416 North State Street  
 Jackson, Mississippi 39201

**CODED**

WATER WELL DRILLERS LOG

6-13 1973 date well completed      Thompson firm name      Madison county well located

LANDOWNER: Corvelas Davis  
Camden, Miss.  
 (mailing address)

description of formations encountered	from	to
	Dirt	0
Red Sand	5	63
Chalk	63	95
Sand	95	131

WELL LOCATION:  
 sec. 3 T. 11N S. R. 5E  
5 miles NE of Camden  
 (distance) (direction) (nearest town)

WELL PURPOSE:  
 (home, irrigation, municipal, industrial)

**CODED**


- WELL COMPLETION DATA:
- (1) diameter (inches) 2
  - (2) total depth (feet) 131
  - (3) static water level (feet) 90  below above top of ground.
  - (4) casing PVC 125  
 (material) (depth)  
2 if telescope see back.  
 (size)
  - (5) screen 6 125  
 (length) (depth to top)  
2" 9 slot PVC  
 (size) (material)
  - (6) pump 1 5  
 (HP) (yield gpm)  
elec.  
 (type power)
  - (7) electric log no  
 (yes or no)
  - (organization running log)
  - (8) how well bottom plugged point

DRILLERS REMARKS:

AUG 24 1973

If well telescopes please sketch and show depths.

GROUND LEVEL

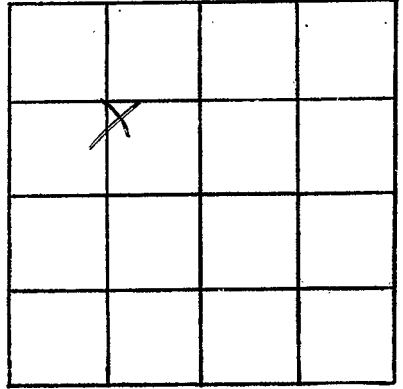

SECTION W

Please indicate well location X.

ADDITIONAL INFORMATION

If more than one screen,  
show locations of each on sketch.