

Madison
E 2000
6/1/76

MISSISSIPPI
BOARD OF WATER COMMISSIONERS
416 North State Street
Jackson, Mississippi 39201

WATER WELL DRILLERS LOG

June 26 1976 THOMAS & SON MADISON
date well completed firm name county well located

LANDOWNER: SALLY WASHINGTON Camden, Miss. (mailing address)	Description of formations encountered	from	to
		feet	feet
	Red Clay	0	6
	Red Sand	6	80
	Sand coarsest at bottom	80	103

WELL LOCATION:
sec. 1 T 11 N R 5 E
6 miles NE of Camden
(distance) (direction) (nearest town)

WELL PURPOSE:
(home, irrigation, municipal, industrial)


- WELL COMPLETION DATA:
- (1) diameter (inches) 2
 - (2) total depth (feet) 103
 - (3) static water level (feet) 80 ^{feet} above top of ground
 - (4) casing PVC 98 (material), (depth)
 - 2 (size) If telescope see back.
 - (5) screen 5 98 (length), (depth to top)
 - 2" 98/10 PVC (size) (material)
 - (6) pump 1 6 (HP) (yield gpm)
 - 3/4 (type power)
 - (7) electric log NO (yes or no)
 - (organization running log)
 - (8) how well bottom plugged Point

DRILLERS REMARKS:

RECEIVED
AUG 16 1976

If well telescopes please sketch and show depths.

GROUND LEVEL

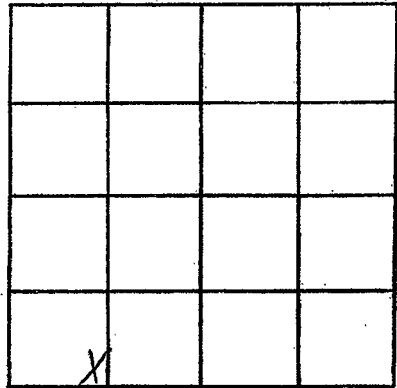

SECTION 1

Please indicate well location X.

ADDITIONAL INFORMATION

If more than one screen, show locations of each on sketch.