

Madison
E 2001
8/76

MISSISSIPPI
BOARD OF WATER COMMISSIONERS
416 North State Street
Jackson, Mississippi 39201

WATER WELL DRILLERS LOG

August 1976 Thomas & Son Madison
date well completed firm name county well located

LANDOWNER: Stella White
Camden, Miss.
(mailing address)

description of formations encountered	from	to
Dirt	0	15
SAND	15	40
fine SAND	40	60
CHALK	60	65
SAND	65	80

WELL LOCATION:
sec. 33 T 11 N R 5 E
S W
3 miles SE of Camden
(distance) (direction) (nearest town)

WELL PURPOSE:
(home, irrigation, municipal, industrial)

- WELL COMPLETION DATA:
- (1) diameter (inches) 2
 - (2) total depth (feet) 80
 - (3) static water level (feet) 45 ⁶⁶ below above top of ground.
 - (4) casing (material) (depth) 74
2 (size) If telescope see back.
 - (5) screen (length) (depth to top) 6 74
2' (size) 3/8 slot (material) PVC
 - (6) pump (HP) (yield gpm) 1 6
Elec. (type power)
 - (7) electric log (yes or no) No

(organization running log)


(8) how well bottom plugged Paint

DRILLERS REMARKS:

RECEIVED
AUG 16 1976

If well telescopes please sketch and show depths.

GROUND LEVEL

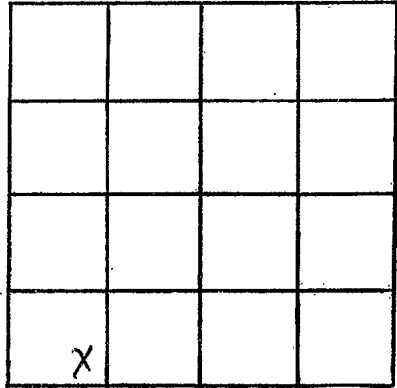

SECTION 33

Please indicate well location X.

ADDITIONAL INFORMATION

If more than one screen,
show locations of each on sketch.