

MADISON  
E 2002  
12/77

MISSISSIPPI  
BOARD OF WATER COMMISSIONERS  
416 North State Street  
Jackson, Mississippi 39201

WATER WELL DRILLERS LOG

Dec. 1977 Thomas & Son Madison  
date well completed firm name county well located

LANDOWNER: Edd Santard description of formations encountered  
Camden, Miss. from to  
Red Clay 0 10  
Red Sand 10 20  
Sand 20 30  
(mailing address) Fine Chalky Sand 30 104  
Coarse Sand 104 115

WELL LOCATION:  
sec. 25 T. 11 N. R. 5 E  
S  
5 1/2 miles E of Camden  
(distance) (direction) (nearest town)

WELL PURPOSE: Chicken House  
(home, irrigation, municipal, industrial)

- WELL COMPLETION DATA:
- (1) diameter (inches) 2
  - (2) total depth (feet) 115
  - (3) static water level (feet) 90 <sup>below</sup>/<sub>above</sub> top of ground.
  - (4) casing Pvc 105  
(material) (depth)  
2 If telescope see back.  
(size)
  - (5) screen 10 105  
(length) (depth to top)  
2" 85/107 Pvc  
(size) (material)
  - (6) pump 1 10  
(HP) (yield gpm)  
E/ea.  
(type power)
  - (7) electric log No.  
(yes or no)
- (organization running log)
- (8) how well bottom plugged Point


RECEIVED

APR - 3 1978

DRILLERS REMARKS: \_\_\_\_\_  
MISS. BO. OF WATER COMMISSIONERS

If well telescopes please sketch and show depths.

GROUND LEVEL

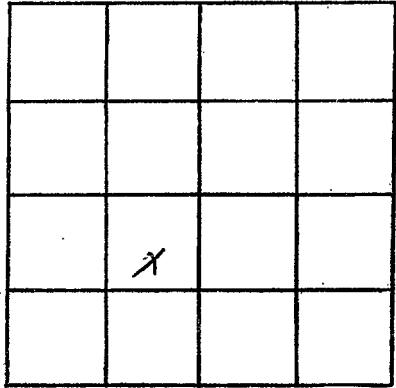

SECTION 25

Please indicate well location X.

ADDITIONAL INFORMATION

If more than one screen,  
show locations of each on sketch.