

MADISON
E 2003

**MISSISSIPPI
BOARD OF WATER COMMISSIONERS**
416 North State Street
Jackson, Mississippi 39201

WATER WELL DRILLERS LOG

Oct-28 1978 Thomas & Son Madison
 date well completed firm name county well located

LANDOWNER: Kirkwood Hunting Club
Thomastown, Miss.
 (mailing address)

description of formations encountered	from to	
	feet	feet
<u>red clay</u>	<u>0</u>	<u>10</u>
<u>red sand</u>	<u>10</u>	<u>50</u>
<u>All sand</u>	<u>50</u>	<u>105</u>

WELL LOCATION:
 sec. 12 T 11 N R 5 E
 S W
19 miles NE of Canton
 (distance) (direction) (nearest town)

WELL PURPOSE: Hunting Club
 (Irrigation, municipal, industrial)

- WELL COMPLETION DATA:
- (1) diameter (inches) 2
 - (2) total depth (feet) 105
 - (3) static water level (feet) 35 below top of ground. above
 - (4) casing pc 100
 (material) (depth)
2 if telescope see back.
 (size)
 - (5) screen 5 100
 (length) (depth to top)
2" 3/8" ot pc
 (size) (material)
 - (6) pump 1 7
 (HP) (yield gpm)
Etc.
 (type power)
 - (7) electric log NO
 (yes or no)
 - (8) how well bottom plugged seal


DRILLERS REMARKS:

RECEIVED
 JAN 3 1978

MISS. BD. OF WATER COMMISSIONERS

If well telescopes please sketch and show depths.

GROUND LEVEL

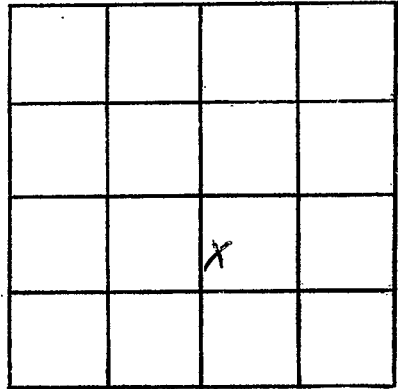

SECTION 12

Please indicate well location X.

ADDITIONAL INFORMATION

If more than one screen, show locations of each on sketch.