

MISSISSIPPI DEPARTMENT OF NATURAL RESOURCES

Bureau of Land and Water Resources

COUNTY WELL LOCATED <i>Madison</i>	
WELL NUMBER <i>E 2008</i>	CODED
DATE WELL COMPLETED <i>10-15-95</i>	

PERMIT NUMBER
NAME OF DRILLING FIRM <i>THOMAS DRILLING</i>

P.O. Box 10631
Jackson, Mississippi 39209
WATER WELL DRILLERS LOG

NAME & MAILING ADDRESS OF LANDOWNER <i>Earnest Jabe</i>		
<i>1236 Cauthen Rd</i>		
<i>Camden</i>		
WELL LOCATION:	SEC	TOWNSHIP
	<i>12</i>	<i>11 S</i>
		RANGE
		<i>5 W</i>
DISTANCE	DIRECTION	NEAREST TOWN
<i>7</i> Miles	<i>NE</i>	of <i>CAMDEN</i>
OTHER LANDMARK <i>1/2 mile S of GAS LINE</i>		
WELL PURPOSE: <input checked="" type="checkbox"/> Home Irrigation, <input type="checkbox"/> Municipal, <input type="checkbox"/> Industrial, <input type="checkbox"/> Fish Pond, etc.		

PUMP DATA		
PUMP TYPE (Circle One): Submersible, Turbine, <input checked="" type="radio"/> Jet, <input type="radio"/> Flowing Well, Other (Describe) _____		
POWER TYPE (Circle One): <input checked="" type="radio"/> Electric, <input type="radio"/> Tractor, <input type="radio"/> Diesel, <input type="radio"/> Gasoline, <input type="radio"/> Butane, Other (Describe) _____		
Pump Capacity (GPM)	No. of Stages	Setting Depth
<i>10'</i>	<i>2</i>	<i>90'</i> FT.
PUMP TEST		
Well yielded <i>7</i> GPM with a drawdown of <i>N/A</i> ft. after _____ hours of pumping		

WELL DATA		
Well Depth <i>100'</i>	Casing Diameter (In.) <i>2"</i>	Casing Length (Ft.) <i>95'</i>
Type of Casing <i>PVC</i>	Hole Depth <i>100'</i>	Depth to Static Water Level <i>75'</i>
TYPE OF COMPLETION: (Circle One or More): Gravel Packed, Underreamed, Telescoped, Natural Development, Open Hole, Other (Describe) <i>SAND</i>		
Top of Lap Pipe or Reduction in Casing		
<input type="checkbox"/> FEET <input type="checkbox"/> IF TELESCOPED OR MORE THAN ONE SCREEN: USE BACK PAGE		

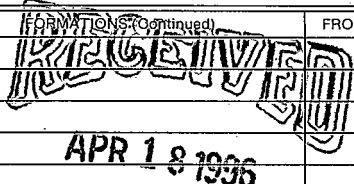
LOG DATA	
TYPE OF LOG RUN (Circle One): Electric, Gamma Ray, Density, Sonic, <input checked="" type="radio"/> No Log Run, Neutron, Other (Describe) _____	
Name of Organization Running Log	

SCREEN DATA		
Diameter - Inches <i>2"</i>	Length - Feet <i>5'</i>	Slot Size - Inches <i>010</i>
Screen Type <i>PVC wrapped</i>	Depth to Bottom - Feet <i>100'</i>	

GEOLOGIC DATA (Office Use Only)			
Surface Elev.	Geologic Unit	Unit Thickness	Depth to Top
Subs. SWL	Date	Analysis	Aquifer Test

Driller's Remarks

DESCRIPTION OF FORMATIONS ENCOUNTERED	FROM	TO
<i>Mixed DIRT</i>	<i>0</i>	<i>5</i>
<i>Mixed CLAY</i>	<i>5</i>	<i>25</i>
<i>SAND</i>	<i>25</i>	<i>100</i>

FORMATIONS (Continued)	FROM	TO
		
APR 18 1996		
Dept. of Environmental Quality Office of Land & Water Resources		
IF MORE SPACE IS NEEDED, USE BACK		

If well telescopes please
sketch and show depths.

GROUND LEVEL

		X	

SECTION 12

Please indicate well location X.

ADDITIONAL INFORMATION

If more than one screen,
show location of each on sketch.