

ELOG # 167

MISSISSIPPI  
BOARD OF WATER COMMISSIONERS  
416 North State Street  
Jackson, Mississippi 39201

**CODED**

WATER WELL DRILLERS LOG

Madison  
F20  
1/68  
Elec log

1968 Lund-Central Co. Madison  
date well completed firm name county well located

LANDOWNER: Big Black  
Water Association, Inc  
Centon, Miss  
(mailing address)

description of formations encountered	from	to
yellow Clay	0	35
Blue Clay, HARD + Soft STKS	35	160
Sandy Clay	160	290
Fine Sand STKS of Shale	290	360
Sandy Clay	360	381
Clay	381	403
Rock	403	409
Clay	409	474
Rock	474	475
Clay-BREAKS OF ROCK	475	506
Sandy Clay, STKS. Sand.	506	727
Sand	727	752
Shale	752	845
Sand	845	926
Shale	926	1004


WELL LOCATION: 5 miles west of  
Centon - Highway 16  
sec. 36 T 10 N R 2 E  
5 miles West of Centon  
(distance) (direction) (nearest town)

WELL PURPOSE: Domestic  
(home, irrigation, municipal, industrial)

WELL COMPLETION DATA:

- (1) diameter (inches) 10"
- (2) total depth (feet) 929
- (3) static water level (feet) 50 below above top of ground.
- (4) casing Steel, 888,  
(material) (depth)  
if telescope see back.  
(size)
- (5) screen 30', 888'  
(length) (depth to top)  
6", Stainless Steel  
(size) (material)
- (6) pump 15 (HP) (yield gpm)  
Electric  
(type power)
- (7) electric log yes  
(yes or no)  
Miss. Geol. Survey  
(organization running log)
- (8) how well bottom plugged Valve

**CODED**

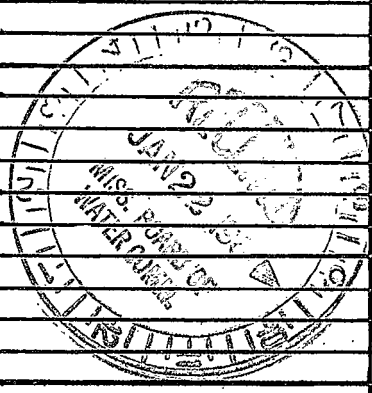


DRILLERS REMARKS:  
Pump not installed as of  
this date - no test  
has been run

If well telescopes please sketch and show depths.

GROUND LEVEL

SW SW NE

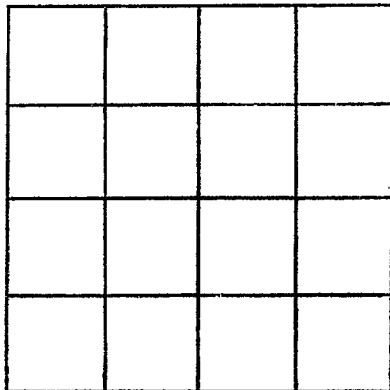

SECTION \_\_\_\_\_

Please indicate well location X.

ADDITIONAL INFORMATION

If more than one screen, show locations of each on sketch.