

MADISON
 T 21
 9-28-70

MISSISSIPPI
 BOARD OF WATER COMMISSIONERS
 416 North State Street
 Jackson, Mississippi 39201

CODED

WATER WELL DRILLERS LOG

Sept 28 1970 John Davis MADISON
 date well completed firm name county well located

LANDOWNER: JOHN GARETT
 Rt 1 CANTON MISS
 (mailing address)

description of formations encountered	from	to
Red Clay + Sand	0	30
Sand	30	33

WELL LOCATION:
 sec 21 T 10 N R 2 E
 7 miles NW of CANTON
 (distance) (direction) (nearest town)

WELL PURPOSE:
 (home, irrigation, municipal, industrial)

- WELL COMPLETION DATA:
- (1) diameter (inches) 6
 - (2) total depth (feet) 33
 - (3) static water level (feet) 10 below above top of ground.
 - (4) casing TILE 33
 (material) (depth)
 (size) if telescope see back.
 - (5) screen NO
 (length) (depth to top)
 (size) (material)
 - (6) pump HAND PUMP
 (HP) (yield gpm)
BUCKET + ROPE
 (type power)
 - (7) electric log (yes or no)
 - (organization running log)
 - (8) how well bottom plugged

CODED


OGI 15 1970

MISS. BD. OF
 WATER COMMISSIONERS

DRILLERS REMARKS:

If well telescopes please sketch and show depths.

GROUND LEVEL

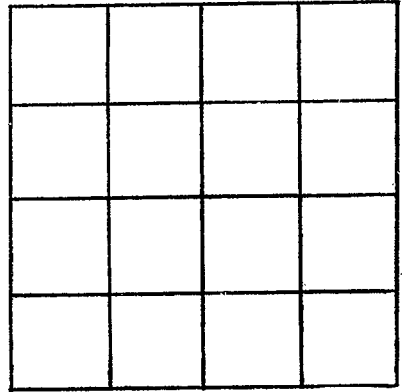

SECTION _____

Please indicate well location X.

ADDITIONAL INFORMATION

If more than one screen, show locations of each on sketch.