

MADISON

F 22

9-22-70

MISSISSIPPI BOARD OF WATER COMMISSIONERS  
416 North State Street  
Jackson, Mississippi 39201

**CODED**

WATER WELL DRILLERS LOG

9-22-70 19  
date well completed

JOHN DAVIS  
firm name

MADISON  
county well located

LANDOWNER: ABE HARRIS

RT 1 CANTON, MS

(mailing address)

description of formations encountered

from

to

Red Clay  
White Clay & Pink  
streak  
SAND

0 20

20 30

30 40

WELL LOCATION:

sec. 21 T. 10 N R. 2 E  
7 miles NW of CANTON  
(distance) (direction) (nearest town)

WELL PURPOSE:

(Home, irrigation, municipal, industrial)

WELL COMPLETION DATA:

**CODED**

- (1) diameter (inches) 6
- (2) total depth (feet) 40
- (3) static water level (feet) 8 below top of ground.
- (4) casing TILE (material), (depth), (size) if telescope see back.
- (5) screen NONE (length), (depth to top), (size), (material)
- (6) pump BUCKET & ROPE (HP), (yield gpm), (type power)
- (7) electric log (yes or no)  (organization running log)
- (8) how well bottom plugged


OCT 15 1970

MISS. BD. OF WATER COMM.

DRILLERS REMARKS:

If well telescopes please sketch and show depths.

GROUND LEVEL

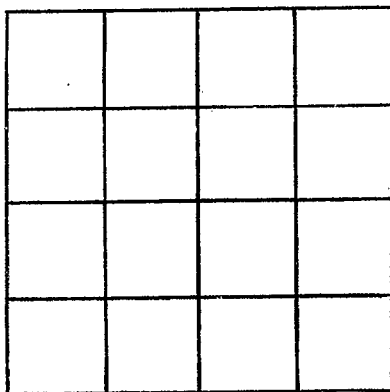

SECTION \_\_\_\_\_

Please indicate well location X.

ADDITIONAL INFORMATION

If more than one screen, show locations of each on sketch.