

MADISON

WATER

LOG

CODED

F 25

Date: Aug 4, 1965, Driller: Mc Kay

County Madison

8-4-65

(1) Owner of Land: Jama Punyard  
 (Name)  
Clinton Miss  
 (Address) 31 10 3E

(2) Location: 1/4, 1/4, Sec. 36 T10R2E,  
5 miles N.W. of Clinton  
 (distance) (direction) (Nearest Town)

(3) Topography:  (Hilly)  (Flat)  (Level)

(4) Purpose of Well: Home  
 (Domestic Irrigation  
 Municipal, Industrial, Other)

Description & Color of Materials Sand, Clay, Red Clay, Shell, etc.	Thick- ness Feet	Depth Feet
<u>white clay</u>	<u>0</u>	<u>20</u>
<u>Blue clay</u>	<u>20</u>	<u>40</u>
<u>Blue clay</u>	<u>40</u>	<u>80</u>
<u>Clay Sand Shm</u>	<u>80</u>	<u>160</u>
<u>Blue clay</u>	<u>160</u>	<u>180</u>
<u>Clay Sand Strm.</u>	<u>180</u>	<u>240</u>
<u>l l l</u>	<u>240</u>	<u>300</u>
<u>Sigite Sand</u>	<u>300</u>	<u>320</u>
<u>l l</u>	<u>320</u>	<u>340</u>
<u>med Sand</u>	<u>340</u>	<u>360</u>

Information upon completion of well:

(1) Diameter 2 inches.

(2) Total Depth 360 feet.

(3) Water Level 66 feet below top of ground.

(4) Cased to \_\_\_\_\_, Size \_\_\_\_\_

(5) Screen: Size 007; Length 10

(6) Were any formations sealed against pollution?  
 \_\_\_\_\_ yes,  no.


air vent.

CODED

If YES depth of formation \_\_\_\_\_

Why \_\_\_\_\_

Drillers Remarks: \_\_\_\_\_

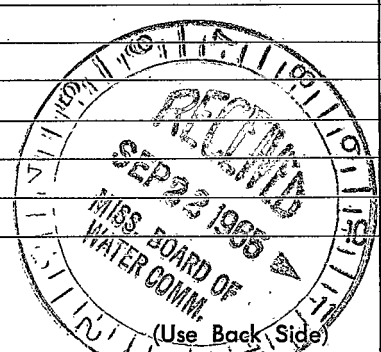

Well No.

