

MISSISSIPPI DEPARTMENT OF NATURAL RESOURCES

Bureau of Land and Water Resources

Southport Mall

P.O. Box 10631

Jackson, Mississippi 39209

WATER WELL DRILLERS LOG

CODED

F 29
~~LAMAR~~ MADISON
 12-3-84

Dec. 3 1984 E.M. Bud Cresswell Madison
 date well completed firm name county well located

LANDOWNER:	description of formations encountered	from	to
Theo COSTAS CANTON, MS. (mailing address)			
WELL LOCATION: sec 20 T 10 N R 2 E 6 miles N.W. of CANTON (distance) (direction) (nearest town)			
WELL PURPOSE: Irrigation (home, irrigation, municipal, industrial)			
WELL COMPLETION DATA:			
(1) diameter (inches) 6			
(2) total depth (feet) 40			
(3) static water level (feet) 15 below top of ground.			
(4) casing PVC, 20 (material), (depth), 6 (size) if telescope see back.			
(5) screen 20, 20 (length), (depth to top), 6, PVC (size), (material)			
(6) pump 3 (HP), 100 (yield gpm)			
(7) electric log No (yes or no)			
(organization running log)			
(8) how well bottom plugged CAP			
DRILLERS REMARKS:			

DEPT. OF NATURAL RESOURCES
 BUREAU OF LAND & WATER RESOURCES


DEC - 7 1984

RECEIVED

(X)

If well telescopes please sketch and show depths.

GROUND LEVEL

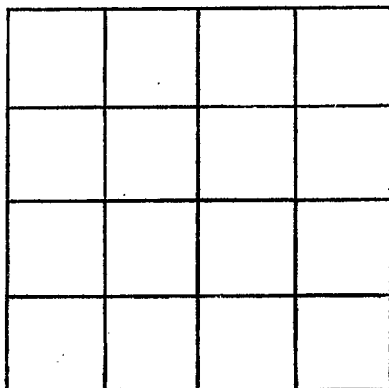

SECTION _____

Please indicate well location X.

ADDITIONAL INFORMATION

If more than one screen,
show locations of each on sketch.