

MADISON

F 2000

WATER WELL DRILLERS LOG

F301

7-18-60

Date July 18, 1960, Driller: MCKAY

County MADISON

(Name)

(1) Owner of Land: HENRY LEE
(Name)

Carleton
(Address) 7 10.3

(2) Location: 1/4, 1/4, Sec. 20 T9 R3E

6 miles NW, of Carleton
(distance) (direction) (Nearest Town)

(3) Topography: (Hilly) (Flat) (Level)

(4) Purpose of Well: Home
(Domestic Irrigation, Municipal, Industrial, Other)

Description & Color of Materials Sand, Clay, Red Clay, Shell, etc.	Thick- ness Feet	Depth Feet
WHITE Clay	0-	21
Rock and clay	21-	42
BLUE Clay	42-	67
Blue Clay	63-	84
Blue " "	84-	105
SANDY Clay	105-	126
" " "	126-	148
FINE SAND	148-	189
" " "	189-	210
MED " "	210-	231
MED to coarse	231-	234

Information upon completion of well:

(1) Diameter 2 inches.

(2) Total Depth 234 feet.

(3) Water Level 43 feet below top of ground.

(4) Cased to _____, Size _____


(5) Screen: Size 006, Length 10ft

(6) Were any formations sealed against pollution?
_____ yes, _____ no.

If YES depth of formation _____

Why _____

Drillers Remarks: _____

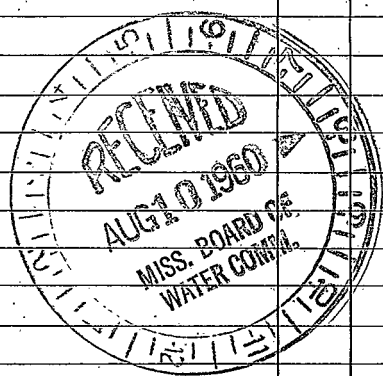

his copy for your office files.

(Use Back Side)

Well No.

