

MISSISSIPPI BOARD OF WATER COMMISSIONERS

MADISON

F ²⁰⁰⁰ WATER WELL DRILLERS LOG

9-12-63

Date: 9/12, 1963, Driller: McRay County Madison
(Name)

(1) Owner of Land: T-P-RANCH
(Name)
RT 1 Canton
(Address)

(2) Location: 1/4, 1/4, Sec. 10 R 3 E
8 miles NW, of Canton
(distance) (direction) (Nearest Town)

(3) Topography: (Hilly) (Flat) (Level)

(4) Purpose of Well: Seed Lot
(Domestic Irrigation, Municipal, Industrial, Other)

Description & Color of Materials Sand, Clay, Red Clay, Shell, etc.	Thick- ness Feet	Depth Feet
<u>yellow clay</u>	<u>0</u>	<u>21</u>
<u>Blue clay</u>	<u>21</u>	<u>42</u>
<u>Massy Brown</u>	<u>42</u>	<u>168</u>
<u>Blue clay</u>	<u>168</u>	<u>210</u>
<u>Sandy clay (Pegmatite)</u>	<u>210</u>	<u>273</u>
<u>" " " "</u>	<u>273</u>	<u>315</u>
<u>" " " "</u>	<u>315</u>	<u>336</u>
<u>med Sand</u>	<u>336</u>	<u>378</u>
<u>" " " "</u>	<u>378</u>	<u>399</u>
<u>" " " "</u>	<u>399</u>	<u>420</u>

Information upon completion of well:

(1) Diameter 2 inches.

(2) Total Depth 420 feet.

(3) Water Level 78 feet below top of ground.

(4) Cased to _____, Size _____.

(5) Screen: Size 007, Length 20.


(6) Were any formations sealed against pollution?
no.

3HP Ann Well
1500 gal tank

If YES depth of formation _____.

Why _____.

Drillers Remarks: _____

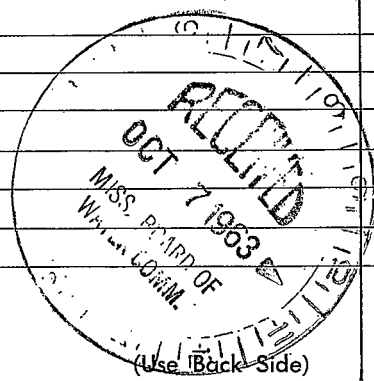

Well No. _____

