

F

2003

11-12-63

WATER WELL DRILLERS LOG

Date: 11/12, 1963, Driller: McKay, County: Madison

(1) Owner of Land: Dr. W.B. Smith (Name) Canton Miss (Address)

(2) Location: 1/4, 1/4, Sec. 10 R 2, 7 miles N.W. of Canton (distance) (direction) (Nearest Town)

(3) Topography: (Hilly) (Flat) (Level)

(4) Purpose of Well: Farm (Domestic Irrigation, Municipal, Industrial, Other)


Table with 3 columns: Description & Color of Materials, Thickness Feet, Depth Feet. Rows include Yellow clay, Brown sandy clay, Blue clay, Sandy clay, Fine sand, and Mud sand.

Information upon completion of well:

- (1) Diameter 2 inches.
(2) Total Depth 315 feet.
(3) Water Level 73 feet below top of ground.
(4) Cased to, Size.
(5) Screen: Size 007, Length 10.
(6) Were any formations sealed against pollution? yes, no.

If YES depth of formation Why

Drillers Remarks:

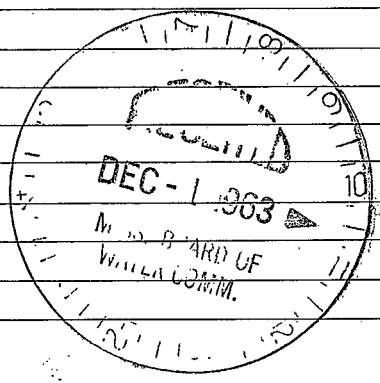

(Use Back Side)

Well No.

