

MAISON MISSISSIPPI BOARD OF WATER COMMISSIONERS

F
4-11-64

2005

WATER WELL DRILLERS LOG

Date: 4/11, 1964, Driller: McKay County: Madison

(1) Owner of Land: T-P RANCH
(Name)
Canton Miss
(Address)

(2) Location: 1/4, 1/4, Sec. 10, R20
5 miles N.W., of Canton
(distance) (direction) (Nearest Town)

(3) Topography: (Hilly) (Flat) (Level)

(4) Purpose of Well: FARM
(Domestic Irrigation, Municipal, Industrial, Other)

Description & Color of Materials Sand, Clay, Red Clay, Shell, etc.	Thick- ness Feet	Depth Feet
weathered clay	17	20
White clay	20	40
Blue clay	40	60
Red clay	60	180
Clay - Sand & Silt	180	200
" " "	200	260
Fine sand	260	280
Med sand	280	320

Information upon completion of well:

(1) Diameter 2 inches.

(2) Total Depth 325 feet.

(3) Water Level 88 feet below top of ground.

(4) Cased to _____, Size _____


(5) Screen: Size 007, Length 10

(6) Were any formations sealed against pollution?
_____ yes, no.

If YES depth of formation _____

Why _____

Drillers Remarks: _____

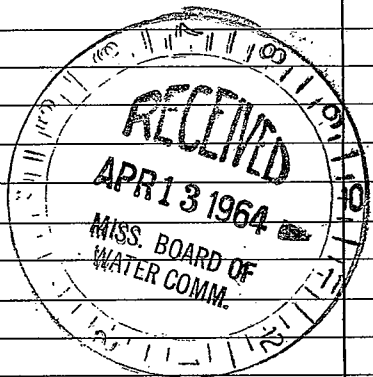

(Use Back Side)

Well No.

