

MADISON MISSISSIPPI BOARD OF WATER COMMISSIONERS

F 2006

WATER WELL DRILLERS LOG

10-13-64

Date: 10/13, 1964, Driller: M. Kay County: Madison

(Name)

(1) Owner of Land: Charlie Williams (Name)

Way Miss (Address)

(2) Location: 1/4, 1/4, Sec. 19 2E

8 miles NW of Canton (distance) (direction) (Nearest Town)

(3) Topography: (Flat) (Level)

(4) Purpose of Well: Home (Domestic Irrigation, Municipal, Industrial, Other)

Description & Color of Materials Sand, Clay, Red Clay, Shell, etc.	Thick- ness Feet	Depth Feet
Brown Clay	0	20
Brown Sandy Clay	20	40
Blue Clay	40	60
Thin Sandy Clay	60	80
" " " "	80	100
med Sand	100-120	
" " " "	120	136
air vent		

Information upon completion of well:

(1) Diameter 2 inches.

(2) Total Depth 136 feet.

(3) Water Level 2.6 feet below top of ground.

(4) Cased to _____, Size _____

(5) Screen: Size 007, Length 10


(6) Were any formations sealed against pollution?

yes, no.

If YES depth of formation _____

Why _____

Drillers Remarks: _____

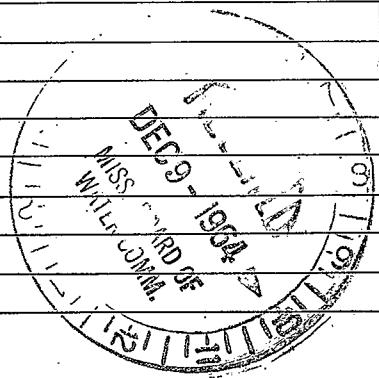

(Use Back Side)

Well No.

10/13

[Faint, illegible handwritten text, possibly bleed-through from the reverse side of the page. Some words like "The" and "and" are barely visible.]

[Extremely faint and illegible handwritten text, likely bleed-through from the reverse side of the page. The content is mostly indistinguishable.]