

MADISON

WATER WELL DRILLERS LOG

F 2007

Date Aug 5, 1965, Driller: McKay, County Madison

8-5-65

(1) Owner of Land: Jensen
 (Name)
Way
 (Address)

(2) Location: 1/4, 1/4, Sec 20 (1) 10N8E
8 miles NW of Center
 (distance) (direction) (Nearest Town)

(3) Topography: (Hilly) (Flat) (Level)

(4) Purpose of Well: Home
 (Domestic Irrigation, Municipal, Industrial, Other)

Description & Color of Materials Sand, Clay, Red Clay, Shell, etc.	Thick- ness Feet	Depth Feet
<u>Red Clay</u>	<u>0</u>	<u>20</u>
<u>Sandy Clay</u>	<u>20</u>	<u>40</u>
<u>Sand clay</u>	<u>40</u>	<u>80</u>
<u>Sand Fine</u>	<u>80</u>	<u>100</u>
<u>med Sand</u>	<u>100</u>	<u>120</u>

Information upon completion of well:

(1) Diameter 2 inches.

(2) Total Depth 120 feet.

(3) Water Level 50 feet below top of ground.

(4) Cased to _____, Size _____

(5) Screen: Size 007, Length 10

(6) Were any formations sealed against pollution?
 _____ yes, no.


1/2 H.P. Jet Pump

63ft Setts

If YES depth of formation _____

Why _____

Drillers Remarks: _____

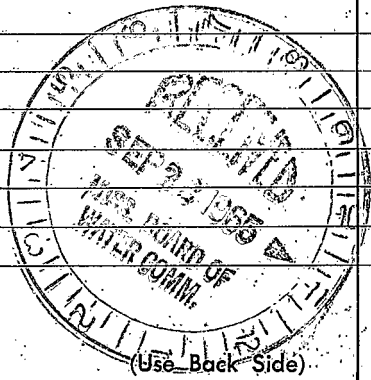

Well No.

