

MISSISSIPPI
BOARD OF WATER COMMISSIONERS
416 North State Street
Jackson, Mississippi 39201

WATER WELL DRILLERS LOG

Madison
G39
6-19-69

6/19/69 date well completed Fount Drilling firm name Madison county well located

LANDOWNER:
Bob H. Rankin
Canton, Miss.
(mailing address)

WELL LOCATION:
sec. 28 T. 10 N. R. 3 E.
1/4 miles (distance) N (direction) of CANTON (nearest town)

WELL PURPOSE: Home
(home, irrigation, municipal, industrial)

WELL COMPLETION DATA:
(1) diameter (inches) 2"
(2) total depth (feet) 306'
(3) static water level (feet) 60' below above top of ground.
(4) casing Galv, 296' (material) (depth)
10' (size) if telescope see back.
(5) screen 10', 296' (length) (depth to top)
2", Stainless Steel (size) (material)
(6) pump BY OWNER (HP) (yield gpm)
20
(type power)
(7) electric log no (yes or no)
(organization running log)
(8) how well bottom plugged 2" Backwash
Valve

description of formations encountered	from	to
Brown clay	0	20
Clay + silt sand	20	81
Sand & silt clay	81	122
Clay	122	163
Fine sand & clay	163	224
Mucky clay + fine sand	224	286
Fine sand + silt clay	286	306
Mucky sand	306	326
Clay	326	349
Shale & silt rock	349	369
Shale	369	376


AUG 1 1969

MISS. BO. OF WATER COMM.

DRILLERS REMARKS:

If well telescopes please sketch and show depths.

GROUND LEVEL

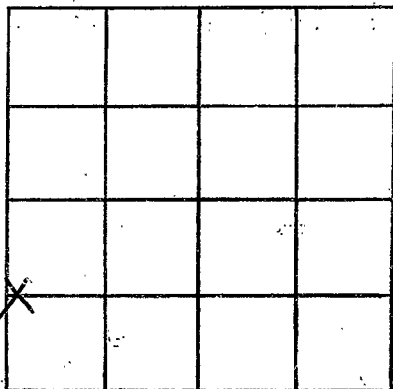

SECTION *28*

Please indicate well location X.

ADDITIONAL INFORMATION

If more than one screen,
show locations of each on sketch.