

SPT

Elog # 193

MADISON
640
5-70

MISSISSIPPI
BOARD OF WATER COMMISSIONERS
416 North State Street
Jackson, Mississippi 39201

Coded
CODED

WATER WELL DRILLERS LOG

MAY-1970 19 DAVID BERRY MADISON
date well completed firm name county well located

LANDOWNER: ROSE HILL CAMP
Rose Hill Camp
~~DUNCAN GARY CENTER~~
Rose Hill, Miss.
(mailing address)

description of formations encountered	from	to
CLAY WITH SAND Bk's	0	34
CLAY	34	50
SAND	50	96
SAND - good	96	248
SAND WITH CLAY STR	248	279
CLAY	279	370
Sample	370	400
SHALE WITH SAND Bk's	400	492
HARD Shale	492	522
SAND	522	610

WELL LOCATION:
sec. 5 T 10 N R 3 E
(distance) miles (direction) of (nearest town)

WELL PURPOSE: MUNICIPAL
(home, irrigation, municipal, industrial)

- WELL COMPLETION DATA:
- (1) diameter (inches) 4 x 2 1/2
 - (2) total depth (feet) 610
 - (3) static water level (feet) _____ below above top of ground.
 - (4) casing A.P.I. Black 580 (material) (depth)
16 if telescope see back. (size)
 - (5) screen 30 580 (length) (depth to top)
2 1/2 STAINLESS (size) (material)
 - (6) pump 5 (HP) (yield gpm)
elec. (type power)
 - (7) electric log Yes (yes or no)
Miss Geo. Survey (organization running log)
 - (8) how well bottom plugged 20' x 1 1/2"

CODED

AUG 13 1970

MISS. BD. OF
WATER COMM.

DRILLERS REMARKS:


If well telescopes please sketch and show depths.

GROUND LEVEL

250'
4"

330'
2 1/2"

300'
Screen

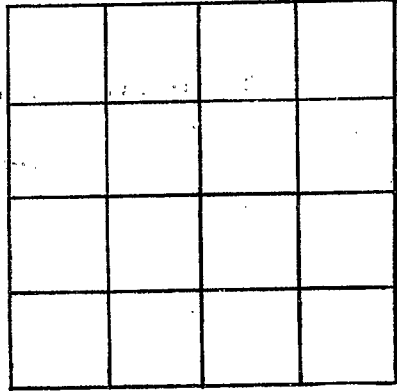

SECTION _____

Please indicate well location X.

ADDITIONAL INFORMATION

Multiple horizontal lines for providing additional information.

If more than one screen, show locations of each on sketch.