

MADISON  
G 41  
8-13-70

MISSISSIPPI  
BOARD OF WATER COMMISSIONERS  
416 North State Street  
Jackson, Mississippi 39201

CODED

WATER WELL DRILLERS LOG

BUTANE GAS CO. OF GREENWOOD

Madison

8/13/70  
date well completed

firm name

county well located

| LANDOWNER:                                                                                                                            | description of formations encountered | from          | to              |
|---------------------------------------------------------------------------------------------------------------------------------------|---------------------------------------|---------------|-----------------|
| R. R. WALLACE<br>Canton, Miss.<br>(mailing address)                                                                                   | Clay<br>Sand + Clay<br>Sand           | 0<br>20<br>60 | 20<br>60<br>129 |
| <b>WELL LOCATION:</b>                                                                                                                 |                                       |               |                 |
| sec. <u>4</u> T. <u>19</u> N. R. <u>3</u> E. <u>087</u><br>8 miles <u>W</u> of <u>Canton</u><br>(distance) (direction) (nearest town) |                                       |               |                 |
| <b>WELL PURPOSE:</b><br>(home, irrigation, municipal, industrial)                                                                     |                                       |               |                 |
| <b>WELL COMPLETION DATA:</b>                                                                                                          |                                       |               |                 |
| (1) diameter (inches) <u>12</u> "                                                                                                     |                                       |               |                 |
| (2) total depth (feet) <u>129</u>                                                                                                     |                                       |               |                 |
| (3) static water level (feet) <u>40</u> below/above top of ground.                                                                    |                                       |               |                 |
| (4) casing <u>Steel</u> <u>89</u><br>(material) (depth)                                                                               |                                       |               |                 |
| <u>12</u> if telescope see back.<br>(size)                                                                                            |                                       |               |                 |
| (5) screen <u>40</u> <u>89</u><br>(length) (depth to top)                                                                             |                                       |               |                 |
| <u>12"</u> <u>Steel</u><br>(size) (material)                                                                                          |                                       |               |                 |
| (6) pump <u>40</u> <u>750</u><br>(HP) (yield gpm)                                                                                     |                                       |               |                 |
| <u>Diesel</u><br>(type power)                                                                                                         |                                       |               |                 |
| (7) electric log <u>No</u><br>(yes or no)                                                                                             |                                       |               |                 |
| (organization running log)                                                                                                            |                                       |               |                 |
| (8) how well bottom plugged <u>Plate</u>                                                                                              |                                       |               |                 |
| <b>DRILLERS REMARKS:</b>                                                                                                              |                                       |               |                 |


CODED

SEP 1 1970

(F)

If well telescopes please sketch and show depths.

GROUND LEVEL

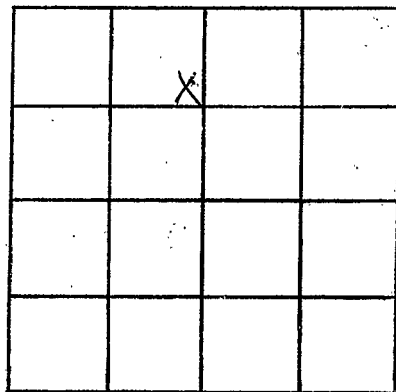

SECTION 4

Please indicate well location X.

ADDITIONAL INFORMATION

If more than one screen, show locations of each on sketch.