

MADISON
G42
9-2-70

MISSISSIPPI
 BOARD OF WATER COMMISSIONERS
 416 North State Street
 Jackson, Mississippi 39201

CODED

WATER WELL DRILLERS LOG

9-2-70 19 70 BUTANE GAS CO. OF GREENWOOD MADISON
 date well completed firm name county well located

LANDOWNER:
R. L. WALLACE
CANTON, MISS.
 (mailing address)

description of formations encountered	from	to
<u>CLAY</u>	<u>0</u>	<u>22</u>
<u>SAND + CLAY</u>	<u>22</u>	<u>55</u>
<u>SAND</u>	<u>55</u>	<u>120</u>

WELL LOCATION:
 sec. 4 T. 19 N. R. 3 E
8 miles N of CANTON
 (distance) (direction) (nearest town)

WELL PURPOSE:
 (home, irrigation, municipal, industrial)

WELL COMPLETION DATA:

(1) diameter (inches) 12"

(2) total depth (feet) 120'

(3) static water level (feet) 38 below above top of ground.

(4) casing Steel 80' below above top of ground.
 (material) (depth)
12" If telescope see back.
 (size)

(5) screen 40' 80'
 (length) (depth to top)
12" Steel
 (size) (material)

(6) pump 40 750
 (HP) (yield gpm)
Diesel
 (type power)

(7) electric log NO
 (yes or no)

(organization running log)

(8) how well bottom plugged Plate

CODED

SEP 4 1970


DRILLERS REMARKS:

MISS. BD. OF
 WATER COMMISSIONERS

(A)

If well telescopes please sketch and show depths.

GROUND LEVEL

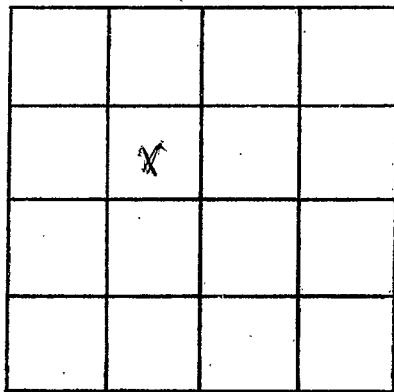

SECTION 2

Please indicate well location X.

ADDITIONAL INFORMATION

If more than one screen,
show locations of each on sketch.