

MADISON  
 G 43  
 70

MISSISSIPPI  
 BOARD OF WATER COMMISSIONERS  
 416 North State Street  
 Jackson, Mississippi 39201

**CODED**

WATER WELL DRILLERS LOG

John Davis

MADISON

date well completed 19 \_\_\_\_\_ firm name \_\_\_\_\_ county well located \_\_\_\_\_

LANDOWNER: JAMES Nicholas  
RT-3 CANTON, MS


Description of formations encountered

from to  
 0 8  
 8 16

Clay  
 Sand

(mailing address)

WELL LOCATION:

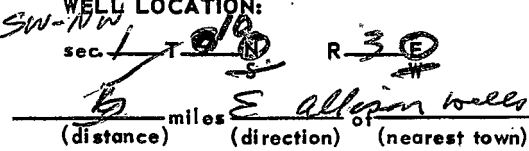

WELL PURPOSE:

(home, irrigation, municipal, industrial)

WELL COMPLETION DATA:

- (1) diameter (inches) 4
- (2) total depth (feet) 16
- (3) static water level (feet) 4 below/above top of ground.
- (4) casing PIPE 14' (material) (depth)  
 (size) If telescope see back.
- (5) screen NONE (length) (depth to top)  
 (size) (material)
- (6) pump BUCKET & ROPE (HP) (yield gpm)  
 (type power)
- (7) electric log (yes or no)
- (organization running log)
- (8) how well bottom plugged \_\_\_\_\_

**CODED**


OCT 15 1970

MISS. DD OF WATER COMM.

DRILLERS REMARKS:

If well telescopes please sketch and show depths.

GROUND LEVEL

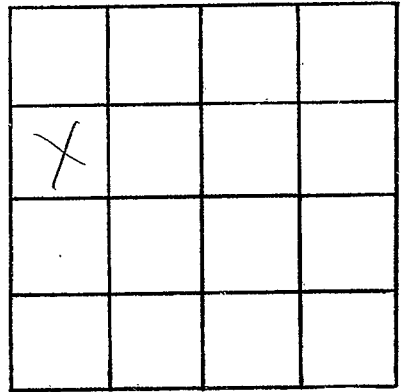

SECTION \_\_\_\_\_

Please indicate well location X.

ADDITIONAL INFORMATION

If more than one screen, show locations of each on sketch.