

MADISON

MISSISSIPPI BOARD OF WATER COMMISSIONERS

OG 45

2-11-63

WATER WELL DRILLERS LOG CODED

Date: Feb 11, 1963, Driller: M. Kay (Name) County: Madison

Form fields for (1) Owner of Land: CH JAMES JR., Canton Miss; (2) Location: 26 T 10 R 35 E, 7 miles NE of CANTON; (3) Topography: Hilly; (4) Purpose of Well: Home

Table with 3 columns: Description & Color of Materials, Thickness Feet, Depth Feet. Entries include Yellow clay, Blue clay, White sandy clay, Brown, Fine Sand, and med. Sand.


Information upon completion of well:

2HP - 2 1/2" air and

- (1) Diameter 2 inches.
(2) Total Depth 244 feet.
(3) Water Level 71 feet below top of ground.
(4) Cased to ... Size ...
(5) Screen: Size 007, Length 10 ft.
(6) Were any formations sealed against pollution? yes, no.

CODED

If YES depth of formation
Why
Drillers Remarks:

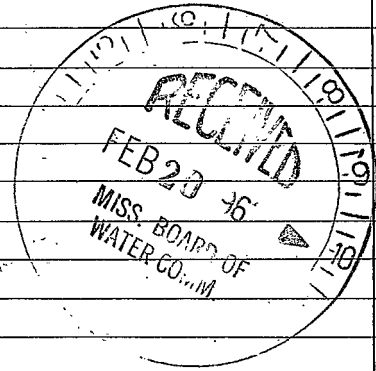

(Use Back Side)

Well No.

