

MADISON

MISSISSIPPI BOARD OF WATER COMMISSIONERS

G-47

5-17-65

WATER WELL DRILLERS LOG

CODED

Date: 5/17, 1965, Driller: MCKAY County: MADISON

(1) Owner of Land: CLIFFORD Goodloe
 (Name)
 Canton Miss.
 (Address)

(2) Location: 1/4, 1/4, Sec. 15 T10 R3E
 7 miles NE of Canton
 (distance) (direction) (Nearest Town)

(3) Topography: (Hilly) (Flat) (Level)

(4) Purpose of Well: Home
 (Domestic Irrigation
 Municipal, Industrial, Other)

Description & Color of Materials Sand, Clay, Red Clay, Shell, etc.	Thick- ness Feet	Depth Feet
Red Clay	0	21
Red Clay	21	26
Red Sand	26	42
Clay - Sand	42	84
Blue Clay	84	105
Blue Clay	105	315
Clay - Sand Stone	315	336
Blue Clay	336	357
Rock	357	399
Blue Clay	399	410
Blue Clay	410	420
Rock	420	425
Sand	425	426
Rock	426	430
Sand	430	434
Sandy clay	434	441
Sandy clay	441	462
Fine Sand	462	504
Med Sand	504	567
	567	588

Information upon completion of well:

(1) Diameter 2 inches.

(2) Total Depth 588 feet.


(3) Water Level 65 feet below top of ground.

(4) Cased to _____, Size _____

(5) Screen: Size 007, Length 20

(6) Were any formations sealed against pollution?
 _____ yes, no.

CODED

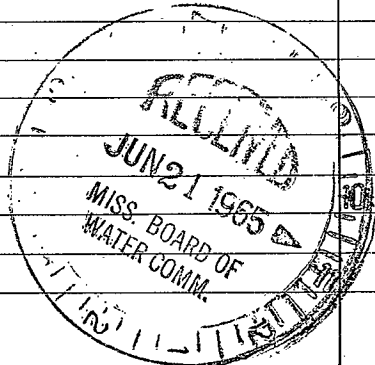

If YES depth of formation _____

Why _____

Drillers Remarks: _____

Well No.

(Use Back Side)

[The page contains extremely faint and illegible text, likely bleed-through from the reverse side of the document. The text is scattered across the page and cannot be transcribed accurately.]