

WG 49

7-23-65

WATER WELL DRILLERS LOG

CODED

Date: 7/27, 1965, Driller: M. Kay County: Madison
(Name)

OTNA

(1) Owner of Land: PTT Walloni
(Name)

Conter
(Address)

(2) Location: 1/4, 1/4, Sec. 12 13 10 3E

8 miles NE, of Conter
(distance) (direction) (Nearest Town)

(3) Topography: (Hilly) (Flat) (Level)

(4) Purpose of Well: (Domestic Irrigation) (Municipal, Industrial, Other)

Description & Color of Materials Sand, Clay, Red Clay, Shell, etc.	Thick- ness Feet	Depth Feet
<u>White Clay</u>	<u>0</u>	<u>20</u>
<u>Blue Clay</u>	<u>20</u>	<u>40</u>
<u>Blue Clay</u>	<u>40</u>	<u>60</u>
<u>Sandy Shale</u>	<u>60</u>	<u>80</u>
<u>Sand</u>	<u>80</u>	<u>160</u>

Information upon completion of well:

(1) Diameter 2 inches.

(2) Total Depth 160 feet.

(3) Water Level 48 feet below top of ground.

(4) Cased to _____, Size _____

(5) Screen: Size 207, Length 10

(6) Were any formations sealed against pollution?
 _____ yes, no.


If YES depth of formation _____

Why _____

Drillers Remarks: _____

at a unit

CODED

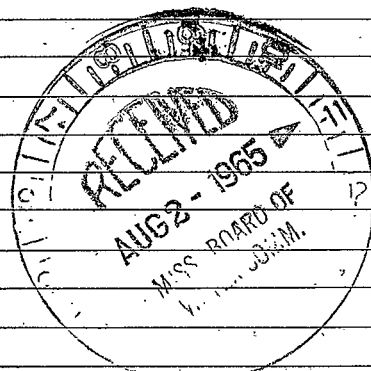

(Use Back Side)

Well No.

1000
1000