

MADISON

MG-50
2-11-66

WATER WELL DRILLERS LOG

CODED

Date: Feb 11, 1966, Driller: MCKAY County: MADISON

Walter Schivner
Spartan

(Name)

(1) Owner of Land: Carter Miss
(Name)
(Address)

(2) Location: 1/4, 1/4, Sec. 31 T10R3E
4 miles N-W of CANTON
(distance) (direction) (Nearest Town)

(3) Topography: [check] (Hilly) (Flat) (Level)

(4) Purpose of Well: HOME
(Domestic Irrigation, Municipal, Industrial, Other)

Description & Color of Materials Sand, Clay, Red Clay, Shell, etc.	Thick- ness Feet	Depth Feet
Red clay	0	10
Sand	10	15
Clay	15	20
Blue clay	20	290
Sand	290	300
Clay	300	304
Med Sand	304	340

Information upon completion of well:

(1) Diameter 2 inches.

(2) Total Depth 340 feet.

(3) Water Level 40 feet below top of ground.

(4) Cased to _____, Size _____

(5) Screen: Size 607, Length 20ft.

(6) Were any formations sealed against pollution?
yes, [check] no.


If YES depth of formation _____

Why _____

Drillers Remarks: _____

Set Red Plug
60ft Selly

CODED

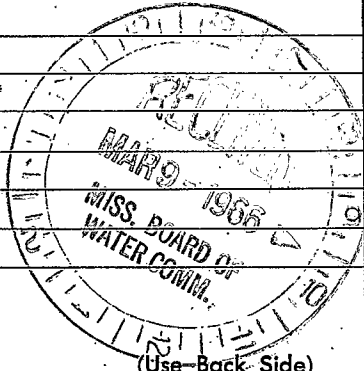

(Use-Back Side)

Well No.

