

**MADISON**  
**G 53**  
**2-13**

MISSISSIPPI  
 BOARD OF WATER COMMISSIONERS  
 416 North State Street  
 Jackson, Mississippi 39201

**CODED**

**WATER WELL DRILLERS LOG**

Feb 1973 Thomas & Son Madison  
 date well completed firm name county well located

LANDOWNER: Sinnie Payton  
Canton, Miss.  
 (mailing address)

description of formations encountered	from	to
<u>DIRT</u>	<u>0</u>	<u>3</u>
<u>CHALK</u>	<u>3</u>	<u>26</u>
<u>SAND CORNICE</u>	<u>26</u>	<u>30</u>
<u>CHALK</u>	<u>30</u>	<u>41</u>
<u>SAND w/ some HARD STRS @ CHALK</u>	<u>41</u>	<u>49</u>

WELL LOCATION:  
 sec. 12 T. 10 N. R. 3 E  
7 miles NE of CANTON  
 (distance) (direction) (nearest town)

WELL PURPOSE:  
 Home, irrigation, municipal, industrial

WELL COMPLETION DATA:

(1) diameter (inches) 2

(2) total depth (feet) 49

(3) static water level (feet) 15  below above top of ground.

(4) casing PVC 41  
 (material) (depth)

2 if telescope see back.  
 (size)

(5) screen 8 41  
 (length) (depth to top)

2 3/4" PVC  
 (size) (material)

(6) pump 3/4 8  
 (HP) (yield gpm)

elec  
 (type power)

(7) electric log NO  
 (yes or no)

(organization running log)

(8) how well bottom plugged Seal


**CODED**

DRILLERS REMARKS:

REC 12 1973

If well telescopes please sketch and show depths.

GROUND LEVEL

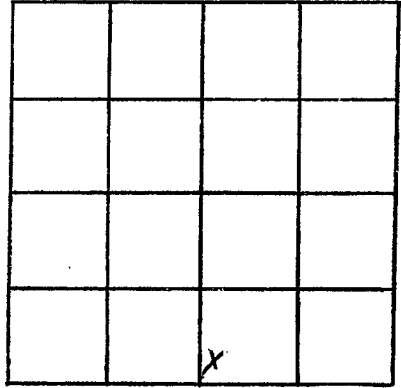

SECTION 12

Please indicate well location X.

ADDITIONAL INFORMATION

If more than one screen,  
show locations of each on sketch.