

MISSISSIPPI
BOARD OF WATER COMMISSIONERS
416 North State Street
Jackson, Mississippi 39201

CODED

WATER WELL DRILLERS LOG

Madison
G 54
1-67

1-22-1967 J.P. Thornton Madison
date well completed firm name county well located

LANDOWNER: Peter Luckett

description of formations encountered	from	to
Yellow Clay	30	30
sand rock	1	31
gray cherts	26	51
fine gray sand	15	68
Black dirt	17	83
White water sand	12	95

Sharon Miss
(mailing address)


WELL LOCATION:
sec. 13 T 10 N R 3 E
7 miles S E of Canton
(distance) (direction) (nearest town)

WELL PURPOSE: Home
(home, irrigation, municipal, industrial)

WELL COMPLETION DATA:

- (1) diameter (inches) 2"
- (2) total depth (feet) 95
- (3) static water level (feet) 55' below above top of ground.
- (4) casing Galv. 88' (material), (depth)
2" (size) if telescope see back.
- (5) screen 1 1/4 x 6 95' (length) (depth to top)
1 1/4" (size), Galv. Brass screen (material)
- (6) pump 1/2 518 P.M. (HP) (yield gpm)
ELECT 110 (type power)
- (7) electric log + (yes or no)
(organization running log)
- (8) how well bottom plugged


CODED

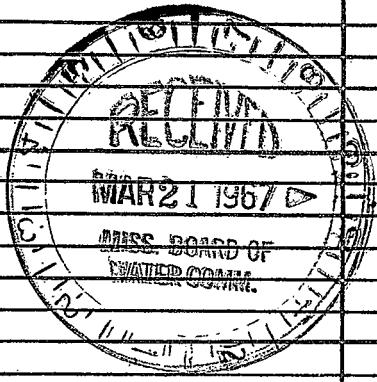

DRILLERS REMARKS: 300 GPH

If well telescopes please sketch and show depths.

GROUND LEVEL

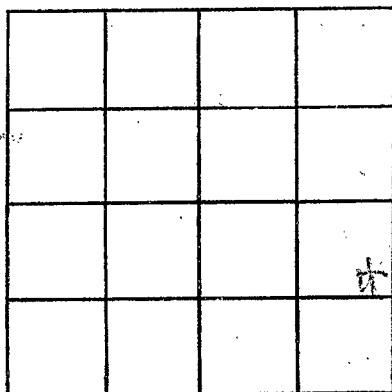

SECTION 13

Please indicate well location X.

ADDITIONAL INFORMATION

If more than one screen, show locations of each on sketch.