

MADISON

G 55

3-10-73

MISSISSIPPI
 BOARD OF WATER COMMISSIONERS
 416 North State Street
 Jackson, Mississippi 39201

CODED

WATER WELL DRILLERS LOG

march-10 1973 John A Davis MADISON
 date well completed firm name county well located

LANDOWNER: MASON

51 NORTH

(mailing address)

WELL LOCATION:

sec. 4 T. 10 N. R. 3 E.
 S. W.
9 miles NORTH of CANTON
 (distance) (direction) (nearest town)

WELL PURPOSE:
 (home, irrigation, municipal, industrial)

WELL COMPLETION DATA:

- (1) diameter (inches) 2"
- (2) total depth (feet) 205'
- (3) static water level (feet) 60 below above top of ground.
- (4) casing Galv, 195',
 (material) (depth)
 (size) if telescope see back.
- (5) screen 16',
 (length) (depth to top)
8 galv Johnson Drains
 (size) (material)
- (6) pump 2, 15'
 (HP) (yield gpm)
Electric
 (type power)
- (7) electric log _____
 (yes or no)

(organization running log)

(8) how well bottom plugged fine

description of formations encountered	from	to
Red clay	0	50
light W.	50	75
Fine WHITE SAND.	75	85
Blue clay	85	105
Sand B. cap.	105	150
" Fine	150	175
" Good	175	205


CODED

DRILLERS REMARKS:

JUN 29 1973

If well telescopes please sketch and show depths.

GROUND LEVEL

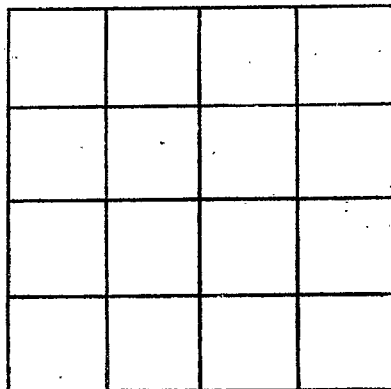

SECTION _____

Please indicate well location X.

ADDITIONAL INFORMATION

If more than one screen,
show locations of each on sketch.