

MADISON  
G56  
3-2-74

MISSISSIPPI  
BOARD OF WATER COMMISSIONERS  
416 North State Street  
Jackson, Mississippi 39201

CODED

WATER WELL DRILLERS LOG

Mar. 2 1974 date well completed  
John A. Davis firm name  
Madison county well located

LANDOWNER: ROBERT BRIDGEMAN  
RFD BRIDGEMAN  
Canton  
(mailing address)

description of formations encountered	from	to
Red clay	0	15
light green clay	15	40
Fine top sand	40	50
Blue clay	50	90
Sand fine	90	125
Blue	125	145
Sand Gravel	145	190

WELL LOCATION:  
sec. 33 T 10 N R 3 E  
4 miles NORTH of Canton  
(distance) (direction) (nearest town)

WELL PURPOSE:  
(home, irrigation, municipal, industrial)

WELL COMPLETION DATA:

(1) diameter (inches) 2"

(2) total depth (feet) 190

(3) static water level (feet) 30 below above top of ground.

(4) casing PVC 170 (material) (depth)

if telescope see back.

(5) screen 20 190 (length) (depth to top)

16 PVC (size) (material)

(6) pump 1 20 (HP) (yield gpm)

Electric (type power)

(7) electric log (yes or no)

(organization running log)

(8) how well bottom plugged Pinned


CODED

MAR 10 1974

DRILLERS REMARKS:

If well telescopes please sketch and show depths.

GROUND LEVEL

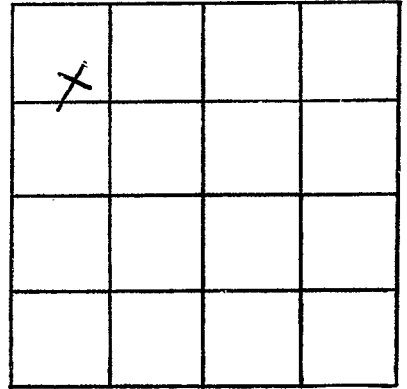

SECTION 33

Please indicate well location X.

ADDITIONAL INFORMATION

If more than one screen,  
show locations of each on sketch.