

MADISON

657

11-15-73

MISSISSIPPI BOARD OF WATER COMMISSIONERS  
416 North State Street  
Jackson, Mississippi 39201

CODED

WATER WELL DRILLERS LOG

Nov-15-1973  
date well completed

John A Davis  
firm name

Madison  
county well located

LANDOWNER: Mrs. ALLEN-WAITS

RFD

Canton

(mailing address)

WELL LOCATION:

sec. 4 T 10 N R 3 E

1/2 miles NORTH of CANTON  
(distance) (direction) (nearest town)

WELL PURPOSE:  
(home, irrigation, municipal, industrial)

WELL COMPLETION DATA: Nov-15-73

- (1) diameter (inches) 2"
- (2) total depth (feet) 90'
- (3) static water level (feet) 30' below top of ground.
- (4) casing PVC 80' (material) (depth)  
10 feet (size) if telescope see back.
- (5) screen 10' (length) (depth to top)  
PVC (material) (size)
- (6) pump 1 H.P. 12 gal (HP) (yield/gpm)  
Electric (type power)
- (7) electric log  (yes or no)  
(organization running log)
- (8) how well bottom plugged pin

description of formations encountered

from

to

Red clay

15'

15'

light clay

15'

27'

fine sand

27'

39'

Blue

39'

57'

Sand streaks

57'

77'

Sand Grad.

77'

90'

CODED

MISSISSIPPI BOARD OF WATER COMMISSIONERS


MAR 16 1974

MISS. BD. OF WATER COMM.

DRILLERS REMARKS:

If well telescopes please sketch and show depths.

GROUND LEVEL

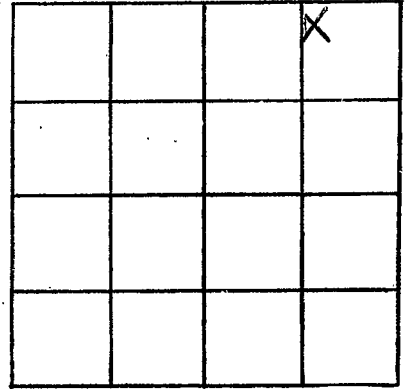

SECTION 4

Please indicate well location X.

ADDITIONAL INFORMATION

A series of horizontal lines for entering additional information.

If more than one screen, show locations of each on sketch.