

MADISON
 G 58
 5-3-74

MISSISSIPPI
 BOARD OF WATER COMMISSIONERS
 416 North State Street
 Jackson, Mississippi 39201 **CODED**

WATER WELL DRILLERS LOG

May-3 1974 date well completed
 J. A. Davis firm name
 Madison county well located

LANDOWNER: James Brown
 old 051 H.Y.

Description of formations encountered	from	to
Red clay	0	50
Grey	50	60
Blue	60	90
Mud	90	105
Blue	105	200
Sand streaks	200	250
Sand	250	295
Blue clay	295	335
Sand	335	390

(mailing address)

WELL LOCATION:
 sec. 27 T. 10 N. R. 3 E
 8 miles N of Canton
 (distance) (direction) (nearest town)

WELL PURPOSE:
 (home, irrigation, municipal, industrial)

WELL COMPLETION DATA:

- (1) diameter (inches) 2"
- (2) total depth (feet) 390
- (3) static water level (feet) 90 below top of ground
- (4) casing PVC 370 (material) (depth)
- (size) if telescope see back.
- (5) screen 20 (length) (depth to top)
 8 PVC (size) (material)
- (6) pump 2 (HP) 20 (yield gpm)
 Elec. (type power)
- (7) electric log (yes or no)
- (organization running log)
- (8) how well bottom plugged Rim

CODED


RECEIVED
 AUG 12 1974

MISS. BD. OF WATER COMMISSIONERS

DRILLERS REMARKS:

If well telescopes please sketch and show depths.

GROUND LEVEL

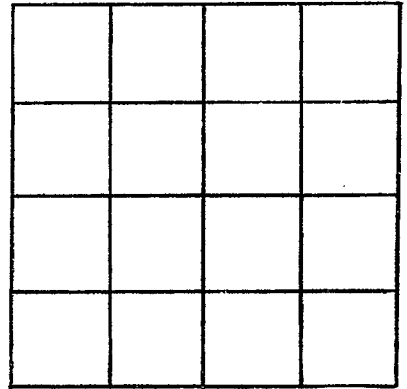

SECTION _____

Please indicate well location X.

ADDITIONAL INFORMATION

If more than one screen,
show locations of each on sketch.