

MADISON
G59
11/15/74

MISSISSIPPI
 BOARD OF WATER COMMISSIONERS
 416 North State Street
 Jackson, Mississippi 39201

CODED

WATER WELL DRILLERS LOG

Nov-15 1974 John A. Davis Madison
 date well completed firm name county well located

LANDOWNER: Milton Cas
Canton, Miss.
 (mailing address)

WELL LOCATION:
 sec 10N R. E
5 miles N of Canton
 (distance) (direction) (nearest town)

WELL PURPOSE: cash
 (home, irrigation, municipal, industrial)

- WELL COMPLETION DATA:
- (1) diameter (inches) 2"
 - (2) total depth (feet) 320
 - (3) static water level (feet) 90' below above top of ground.
 - (4) casing 2" PVC, 310
 (material) (depth)
no if telescope see back.
 (size)
 - (5) screen 10'
 (length) (depth to top)
10 Slot, PVC
 (size) (material)
 - (6) pump 3H.P., 20 gal.
 (HP) (yield gpm)
Elect.
 (type power)
 - (7) electric log no
 (yes or no)
 (organization running log)
 - (8) how well bottom plugged Pen.


description of formations encountered	from	to
Red clay	0	40
Gray clay	40	60
Blue	60	90
Muda Branch	90	105
Blue	105	205
Top of Coy Field	205	215
Thin sand	215	250
Sand streak		
Blue	250	275
Sand Good	275	320

DRILLERS LOG
FEB 19 1975
 MISSISSIPPI BOARD OF WATER COMMISSIONERS

DRILLERS REMARKS:
Good drilling

If well telescopes please sketch and show depths.

GROUND LEVEL

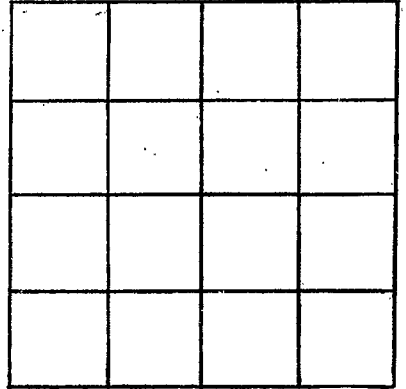

SECTION _____

Please indicate well location X.

ADDITIONAL INFORMATION

If more than one screen, show locations of each on sketch.