

G 2000

10-20-62

WATER WELL DRILLERS LOG

Date: Oct 20, 1962, Driller: M. H. King, County: Madison

(1) Owner of Land: James A. Cook  
 (Name)  
Waymond  
 (Address)

(2) Location: 1/4, 1/4, Sec. 10 NE  
1 miles SE of WAY  
 (distance) (direction) (Nearest Town)

(3) Topography:  (Hilly)  (Flat)  (Level)

(4) Purpose of Well: Home  
 (Domestic Irrigation, Municipal, Industrial, Other)

Description & Color of Materials Sand, Clay, Red Clay, Shell, etc.	Thick- ness Feet	Depth Feet
Red Clay	0	10
White Clay	10	21
Blue Clay - Sand	21	44
Blue Clay	42	63
	67	84
Sandy Clay	84	105
	105	126
Fine Sand	126	147
Sand with Gravel	147	168
Well Sand	168	189
Well Sand	189	200

Information upon completion of well:

(1) Diameter 2 inches.

(2) Total Depth 200 feet.

(3) Water level 34 feet below top of ground.

(4) Cased to \_\_\_\_\_, Size \_\_\_\_\_

(5) Screen: Size 007, Length 10

(6) Were any formations sealed against pollution?  
 \_\_\_\_\_ yes,  no.


If YES depth of formation \_\_\_\_\_

Why: \_\_\_\_\_

Drillers Remarks: \_\_\_\_\_

\_\_\_\_\_

\_\_\_\_\_

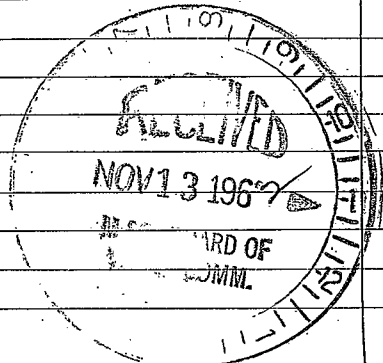

(Use Back Side)

Well No.

