

2004

WATER WELL DRILLERS LOG

Date: July, 1978, Driller: Thomas Drilling County Madison
(When well drilled) (Name) (Where well is located)

(1) Owner of Land: Billy Cooper
(Name)
Canton, Miss.
(Address)
(2) Location: NW 1/4, NW 1/4, Sec. 27 T10R3,
5 miles NE of Canton,
(distance) (direction) (Nearest Town)
(3) Topography: (Hilly) (Flat) (Level)
(4) Purpose of Well: (Domestic) Irrigation
Municipal, Industrial, Other)

Description & Color of Materials Sand, Clay, Red Clay, Shell, etc.	Thick- ness Feet	Depth Feet
Dirt	0	10
yellow & white CHALK	10	55
Grey CHALK	55	105
SAND & CHALK STKS.	105	152
Mostly CHALK	132	210
SAND COURSER AT TOP	210	231

Information upon completion of well:

(1) Diameter 2 inches.
(2) Total Depth 231 feet.
(3) Water Level 95 feet below top of ground.
(4) Cased to 211, Size 2"
(5) Screen: Size 2" 8s/ot, Length 20ft.
(6) Were any formations sealed against pollution?
yes, No no.

If YES depth of formation

Why

Drillers Remarks:


Yield in gpm: 15

Size pump: 2 H.P. Air Comp

Type power: Elec.

RECEIVED
JUL 28 1978

MISS. BD. OF WATER COMM

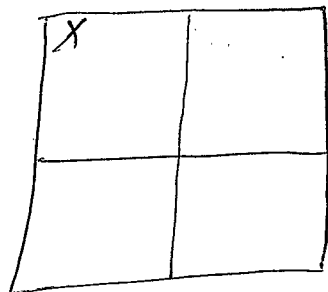

Sec. 27