

H

5-8-65

WATER WELL DRILLERS LOG

Date: 5/8/65, 19, Driller: M Kay County: Madison

(1) Owner of Land: Johnson (Name) Canton, Miss (Address)
(2) Location: 1/4, 1/4, Sec. T, R, 1.2 miles NE of Canton (distance) (direction) (Nearest Town)
(3) Topography: (Hilly) (Flat) (Level)
(4) Purpose of Well: Farm (Domestic Irrigation Municipal, Industrial, Other)

Table with 4 columns: Description & Color of Materials, Thickness Feet, Depth Feet. Rows include: To Seal, White Clay, Fine Sand, Med Sand, Coarse Sand.


Information upon completion of well:

(1) Diameter 2 inches.
(2) Total Depth 89 feet.
(3) Water Level 22 feet below top of ground.
(4) Cased to, Size
(5) Screen: Size 007, Length 5 ft.
(6) Were any formations sealed against pollution? yes, no.

If YES depth of formation
Why

Drillers Remarks:

Handwritten signature

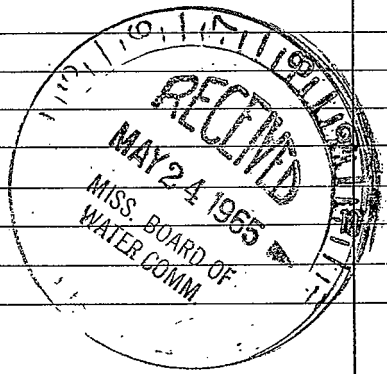

(Use Back Side)

Well No.

