

MADISON

WATER WELL DRILLERS LOG

CODED

H17

8-4-60

Date Aug 11, 1960, Driller: M^{rs}. Kay Dally

County Madison

(Name)

(1) Owner of Land: SESSUM
(Name)
SHARON MISS
(Address)

(2) Location: 1/4, 1/4, Sec. 27 T10RE4E
6 miles E of SHARON
(distance) (direction) (Nearest Town)

(3) Topography: (Hilly) (Flat) (Level)

(4) Purpose of Well: HOME
(Domestic Irrigation
Municipal, Industrial, Other)

Description & Color of Materials Sand, Clay, Red Clay, Shell, etc.	Thick- ness Feet	Depth Feet
<u>YELLOW CLAY</u>	<u>0</u>	<u>21</u>
<u>"</u>	<u>21</u>	<u>42</u>
<u>BROWN CLAY</u>	<u>17</u>	<u>63</u>
<u>"</u>	<u>63</u>	<u>84</u>
<u>"</u>	<u>84</u>	<u>105</u>
<u>SANDY CLAY</u>	<u>105</u>	<u>126</u>
<u>"</u>	<u>126</u>	<u>147</u>
<u>"</u>	<u>147</u>	<u>168</u>
<u>SAND - Clay</u>	<u>148</u>	<u>189</u>
<u>"</u>	<u>189</u>	<u>210</u>
<u>MED SAND & GRAVEL</u>	<u>210</u>	<u>234</u>

Information upon completion of well:

(1) Diameter 2 inches.

(2) Total Depth 234 feet.

(3) Water Level 65 feet below top of ground.

(4) Cased to _____, Size _____

(5) Screen: Size 007, Length X10

(6) Were any formations sealed against pollution?
_____ yes, no.

235 - BLUE SHADE

SET Screen
234


all Pumping

CODED

If YES depth of formation _____

Why _____

Drillers Remarks: _____

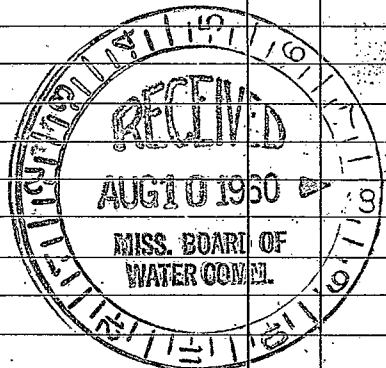

Well No.

(Use Back Side)

this copy for your office files.

1948

...

...

