

H18

6-18-63

WATER WELL DRILLERS LOG

CODED

Date: 6/18, 1963, Driller: M^o Ray County: Madison

(1) Owner of Land: Sharon
 (Name)
Sharon Moore
 (Address)

(2) Location: 1/4, 1/4, Sec. 29 T10 R9
7 miles S.W. of Camden
 (distance) (direction) (Nearest Town)

(3) Topography: (Hilly) (Flat) (Level)

(4) Purpose of Well: Home
 (Domestic Irrigation
 Municipal, Industrial, Other)

Description & Color of Materials Sand, Clay, Red Clay, Shell, etc.	Thick- ness Feet	Depth Feet
Red Clay	0	21
White Clay	21	42
Sandy White Clay	42	105
Fine Sandy Clay	105	147
Med Clay (Pink)	147	168
Sand & Gravel	168	294
Fine Sandy Clay	294	315
Rock	315	319
Red STRAY SAND	319	462
Med Sand	462	483
Med Sand	483	506

Information upon completion of well:

(1) Diameter 2 inches.

(2) Total Depth 506 feet.

(3) Water Level 68 feet below top of ground.

(4) Cased to _____, Size _____

(5) Screen: Size 007, Length 20


(6) Were any formations sealed against pollution?
 _____ yes, no.

If YES depth of formation _____

Why _____

Drillers Remarks: _____

CODED

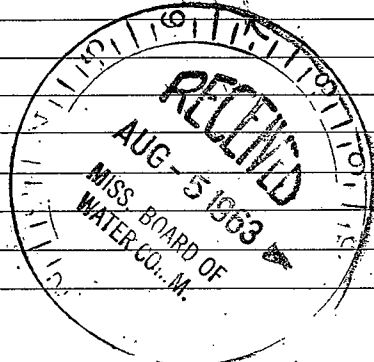

(Use Back Side)

Well No.

