

H 19
7-2-64

WATER WELL DRILLERS LOG

CODED

Date: 7/2, 1964, Driller: M^cKay County Madison
(Name)


- (1) Owner of Land: E. P. Hall
(Name)
Sharon
(Address)
- (2) Location: 1/4, 1/4, Sec. 26 TO R4E,
12 miles NE of Canton
(distance) (direction) (Nearest Town)
- (3) Topography: (Hilly) (Flat) (Level)
- (4) Purpose of Well: Home
(Domestic Irrigation
Municipal, Industrial, Other)

Information upon completion of well:

- (1) Diameter 2 inches.
- (2) Total Depth 460 feet.
- (3) Water Level 44 feet below top of ground.
- (4) Cased to _____, Size _____
- (5) Screen: Size 007, Length 20
- (6) Were any formations sealed against pollution?
_____ yes, no.

If YES depth of formation _____
Why _____
Drillers Remarks: _____

Description & Color of Materials Sand, Clay, Red Clay, Shell, etc.	Thick- ness Feet	Depth Feet
<u>White Clay</u>	<u>0</u>	<u>20</u>
<u>White Clay</u>	<u>20</u>	<u>40</u>
<u>Blue Clay Sand</u>	<u>40</u>	<u>60</u>
<u>Sand</u>	<u>60</u>	<u>80</u>
<u>Clay - Sand</u>	<u>80</u>	<u>100</u>
<u>Brown Sand</u>	<u>100</u>	<u>120</u>
<u>Green Sand - Shale</u>	<u>120</u>	<u>140</u>
" " "	<u>140</u>	<u>160</u>
" " "	<u>160</u>	<u>180</u>
<u>Fine Sandy Clay</u>	<u>180</u>	<u>200</u>
" " "	<u>200</u>	<u>220</u>
" " "	<u>220</u>	<u>240</u>
" " CODED	<u>240</u>	<u>260</u>
" " "	<u>260</u>	<u>280</u>
" " "	<u>280</u>	<u>300</u>
<u>Rock - Stone - Sand</u>	<u>300</u>	<u>320</u>
<u>Fine Sand</u>	<u>320</u>	<u>340</u>
" " "	<u>340</u>	<u>360</u>
" " "	<u>360</u>	<u>380</u>
<u>Fine Sand</u>	<u>380</u>	<u>400</u>
<u>Fine Sand - Clay</u>	<u>400</u>	<u>420</u>
<u>Fine Sand</u>	<u>420</u>	<u>440</u>
<u>med Sand</u>	<u>440</u>	<u>460</u>

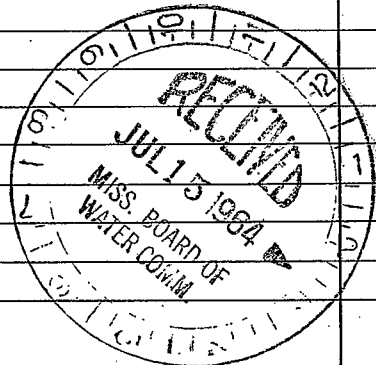

(Use Back Side)

Well No.

