

H 20

6-18-66

WATER WELL DRILLERS LOG

CODED

Date: 6-18, 1966, Driller: J P Sheraton County Madison
 (Name)

(1) Owner of Land: Williams Reynolds
 (Name)
Farm House Mess
 (Address)

(2) Location: 1/4, 1/4, Sec. 26 T10 R4E
5 miles N.W., of Farmhouse
 (distance) (direction) (Nearest Town)

(3) Topography: _____
 (Hilly) (Flat) (Level)

(4) Purpose of Well: Domestic
 (Domestic Irrigation
 Municipal, Industrial, Other)

Description & Color of Materials Sand, Clay, Red Clay, Shell, etc.	Thick- ness Feet	Depth Feet
<u>red clay</u>	<u>10</u>	
<u>yellow sand</u>	<u>25</u>	
<u>white chalk</u>	<u>10</u>	
<u>fine white sand</u>	<u>20</u>	
<u>gray water sand</u>	<u>15</u>	
	<u>110</u>	

Information upon completion of well:

(1) Diameter 2 inches.

(2) Total Depth 110 feet.

(3) Water Level 50 feet below top of ground.

(4) Cased to 105', Size 2

(5) Screen: Size 1 1/4, Length 3 ft

(6) Were any formations sealed against pollution?


_____ yes, _____ no.

If YES depth of formation _____

Why _____

Drillers Remarks: 390 gal per hr

CODED

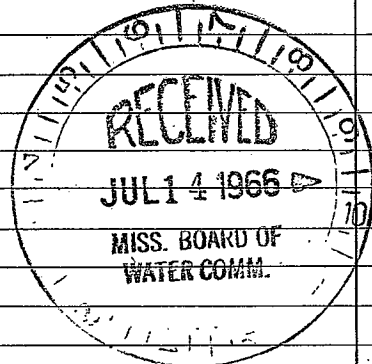

(Use Back Side)

Well No.

100-100000

100-100000