

Madison  
H21  
3-67

MISSISSIPPI  
BOARD OF WATER COMMISSIONERS  
416 North State Street  
Jackson, Mississippi 39201

WATER WELL DRILLERS LOG

**CODED**

3-10 - 1967 J.P. Thornton Madison County  
date well completed firm name county well located

LANDOWNER: B. Luereth

P.O. Box 99

Camden Miss  
(mailing address)

description of formations encountered

from to

red clay	21	21
chert sand	21	42
gray chert	42	84
gray water sand	18	102

WELL LOCATION:


sec. 2 T 10 N R 4 E  
S W  
4 miles S of Camden  
(distance) (direction) (nearest town)

WELL PURPOSE: Home  
(home, irrigation, municipal, industrial)

WELL COMPLETION DATA:

- (1) diameter (inches) 2
- (2) total depth (feet) 102
- (3) static water level (feet) 42 below above top of ground.
- (4) casing 36 Gal 96 (material), (depth)  
2<sup>1</sup>/<sub>2</sub> (size) if telescope see back.
- (5) screen 14x6 (length), 102 (depth to top)  
1/4 (size), Bross screen (material)
- (6) pump 1/2 (HP), 61 GPM (yield gpm)  
Electric 110 (type power)
- (7) electric log X (yes or no)  
(organization running log)
- (8) how well bottom plugged


**CODED**

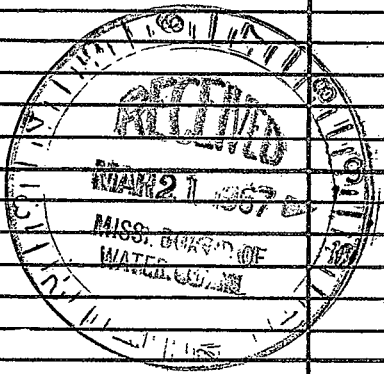

DRILLERS REMARKS: 366 GPM

If well telescopes please sketch and show depths.

GROUND LEVEL

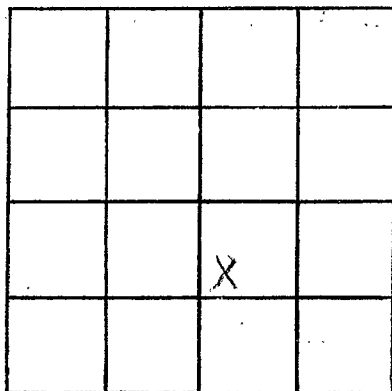

SECTION 2

Please indicate well location X.

ADDITIONAL INFORMATION

If more than one screen,  
show locations of each on sketch.